


CERTIFIED RECORD OF LAND CORNER MONUMENTATION

U.S.F.S. INDEX No. E-3

History of original corner establishment: This corner was originally established by Zenas F. Moody in 1873, under GLO Contract No. 184.

DIAGRAM

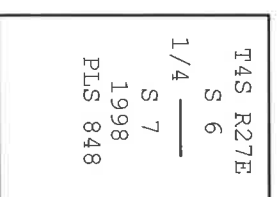

Surveyor General Field Notes State:

Set post in earth mound for 1/4 sec. cor.

Description of Corner Evidence Found:

No original corner evidence found. Set a proportionate measure from the corners 1/2 mile east and 1/2 mile west.

Description of monument and accessories I established to perpetuate the original location of this corner:

At the proportionate position, Set a 2-1/2"x30" aluminum pipe with 2-1/2" aluminum cap, stamped as shown in DIAGRAM, 26" in the ground.


From which:

Set a 5/8"x30" iron pins with plastic caps stamped PLS 848 at the following bearings and distances:

- N40°38'W, 23.29 ft., three grooves in top of pin.
- N50°05'E, 25.65 ft., no grooves
- S41°34'E, 24.52 ft., one groove in top of pin.
- S51°36'W, 26.47 ft., two grooves in top of pin.

Measurements to accessories taken with a Wild TC1600 Total Station

This work was performed by:
Douglas M. Ferguson, PLS 848
Witnessed by: D. Mitchell Ferguson
and Brad Cates
Date: 4-17-98

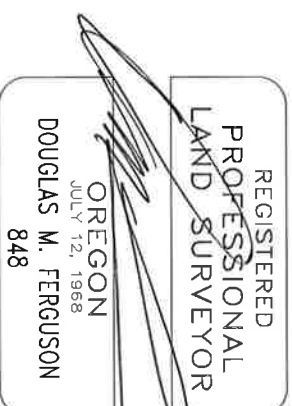

Office of Surveyor, County of Morrow, State of Oregon,
I hereby certify that the within instrument was
filed in this office for record on the 23 day of August, 2013

Stalin V. Black by _____
(COUNTY OFFICIAL) (DEPUTY)

Refer to Morrow County Map No. 2013-34D