


CERTIFIED RECORD OF LAND CORNER MONUMENTATION

U.S.F.S. INDEX No. E-5

History of original corner establishment: This corner was originally established by Zenas F. Moody in 1873, under GIO Contract No. 184.

DIAGRAM

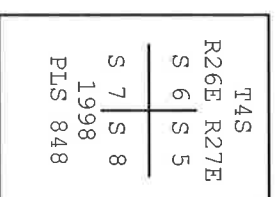

Surveyor General Field Notes State:

Set post in a stone mound for Cor to Secs 7-8-5-6

Description of Corner Evidence Found:

No original corner evidence found. Set at double proportionate measure from the corners 1 mile north, 1-1/2 miles south, 1/2 mile east and 1 mile west.

Description of monument and accessories I established to perpetuate the original location of this corner:

At the proportionate position, Set a 2-1/2"x30" aluminum pipe with 2-1/2" aluminum cap, stamped as shown in DIAGRAM, 26" in the ground.


From which:

Set a 5/8"x30" iron pins with plastic caps stamped PLS 848 at the following bearings and distances:

- N61°40'W, 19.56 ft., no grooves
- N21°34'E, 19.01 ft., one groove in top of pin.
- S38°52'E, 26.12 ft., two grooves in top of pin.
- S12°43'W, 20.39 ft., three grooves in top of pin.

Measurements to accessories taken with a Wild TC1600 Total Station

This work was performed by:
Douglas M. Ferguson, PLS 848
Witnessed by: D. Mitchell Ferguson
and Brad Cates
Date: 4-18-98

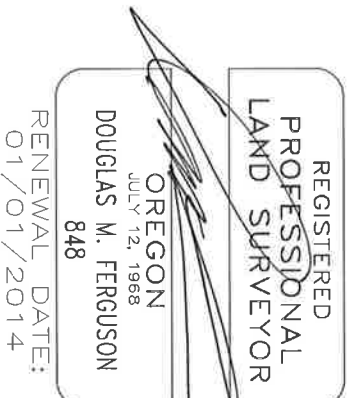

Office of Surveyor, County of Morrow, State of Oregon,
I hereby certify that the within instrument was
filed in this office for record on the 23 day of August, 2013

Debra K. Alford by _____
(COUNTY OFFICIAL) (DEPUTY)

Refer to Morrow County Map No. 2013-34D