


CERTIFIED RECORD OF LAND CORNER MONUMENTATION

U.S.F.S. INDEX No. E-7

History of original corner establishment: This corner was originally established by Zenas F. Moody in 1873, under GIO Contract No. 184.

DIAGRAM

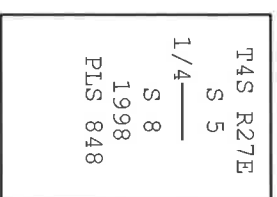

Surveyor General Field Notes State:

Set stone 14x11x5 for 1/4 sec. cor.

Description of Corner Evidence Found:

Found 14x11x5 stone set firmly in the ground, marked 1/4 on the west face.

Description of monument and accessories I established to perpetuate the original location of this corner:

At the position of the corner stone, Set a 2-1/2"x30" aluminum pipe with 2-1/2" aluminum cap, stamped as shown in DIAGRAM, 28" in the ground, placed original stone north alongside pipe.

From which:

Set a 5/8"x30" iron pins with plastic caps stamped PLS 848 at the following bearings and distances:

- N29°W, 11.5 ft., no grooves
- N58°E, 10.9 ft., one groove in top of pin.
- S30°E, 8.3 ft., two grooves in top of pin.
- S63°W, 10.5 ft., three grooves in top of pin.


Measurements to accessories taken with a magnetic compass, declination 17° east, and a nylon clad steel tape.

This work was performed by:

Douglas M. Ferguson, PLS 848

Witnessed by: D. Mitchell Ferguson and Brad Cates

Date: 4-18-98

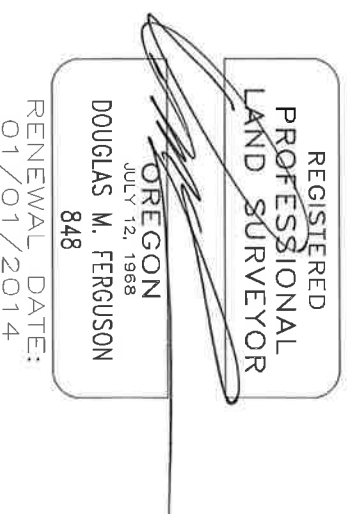

Office of Surveyor, County of Morrow, State of Oregon,
I hereby certify that the within instrument was
filed in this office for record on the 23 day of August, 2013

Stacy E. Maxwell by _____
(COUNTY OFFICIAL) (DEPUTY)

Refer to Morrow County Map No. 2013-34D