

CERTIFIED RECORD OF LAND CORNER MONUMENTATION

U.S.F.S. INDEX No. G-1

History of original corner establishment: This corner was originally established by Zenas F. Moody in 1873, under GJO Contract No. 184.

DIAGRAM

T4S
R26E R27E
1/4
S12 S 7
1998
PLS 848

Surveyor General Field Notes State:

Set stone 10x10x6 for 1/4 sec. cor.

Description of Corner Evidence Found:

No original corner evidence found. Set a proportionate measure from the corners 1/2 mile north and 1/2 mile south.

Description of monument and accessories I established to perpetuate the original location of this corner:

At the proportionate position, Set a 2-1/2"x30" aluminum pipe with 2-1/2" aluminum cap, stamped as shown in DIAGRAM, 25" in the ground.


From which:

Set a 5/8"x30" iron pins with plastic caps stamped PLS 848 at the following bearings and distances:

- N51°W, 9.2 ft.
- N39°E, 8.8 ft., one groove in top of pin.
- S51°E, 9.8 ft., two grooves in top of pin.
- S42°W, 10.0 ft., three grooves in top of pin.

Measurements to accessories taken with a magnetic compass, declination 17° east, and a nylon clad steel tape.

This work was performed by:
Douglas M. Ferguson, PLS 848
Witnessed by: D. Mitchell Ferguson
and Brad Cates
Date: 4-20-98

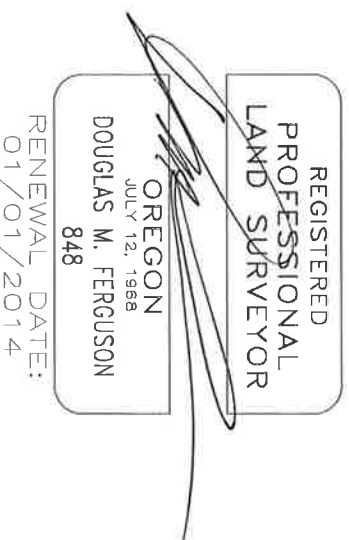

Office of Surveyor, County of Morrow, State of Oregon,
I hereby certify that the within instrument was
filed in this office for record on the 23 day of August, 2013

Dylan K. Wood by _____
(COUNTY OFFICIAL) (DEPUTY)

Refer to Morrow County Map No. 2013-34D