


CERTIFIED RECORD OF LAND CORNER MONUMENTATION

U.S.F.S. INDEX No. G-2

History of original corner establishment: This corner was not originally established.

DIAGRAM

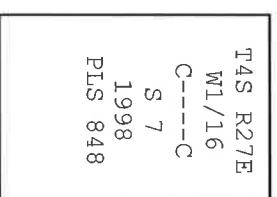

Description of Corner Evidence Found:

This corner was not originally established.

Description of monument and accessories I established to perpetuate the original location of this corner:

Set a 5/8"x30" iron pin with a 1-1/2" aluminum cap, stamped as shown in DIAGRAM, 22" in the ground, placed a ring of stone around pin.

From which:

Set a 5/8"x30" iron pins with plastic caps stamped PLS 848 at the following bearings and distances:

N01°35'E, 25.22 ft.

S86°25'E, 24.38 ft.


Measurements to accessories taken with a Wild TC1600 Total Station

This work was performed by:

Douglas M. Ferguson, PLS 848

Witnessed by: D. Mitchell Ferguson
and Brad Cates

Date: 4-18-98

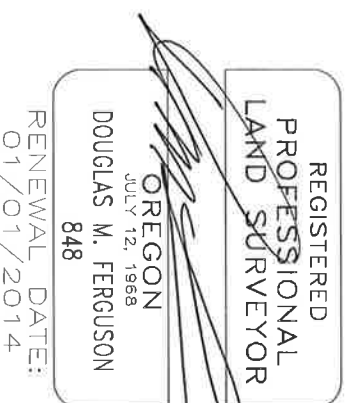

Office of Surveyor, County of Morrow, State of Oregon,
I hereby certify that the within instrument was
filed in this office for record on the 23 day of August, 2013

Stalin K. Adland by _____
(COUNTY OFFICIAL) (DEPUTY)

Refer to Morrow County Map No. 2013-34D