


**CERTIFIED RECORD OF LAND CORNER MONUMENTATION**

U.S.F.S. INDEX No. G-3

**History of original corner establishment:** This corner was not originally established.

**DIAGRAM**

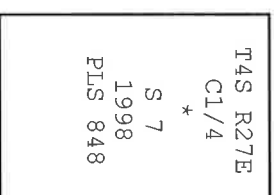

**Description of Corner Evidence Found:**

This corner was not originally established.

**Description of monument and accessories I established to perpetuate the original location of this corner:**

Set a 2-1/2"x30" aluminum pipe with 2-1/2" aluminum cap, stamped as shown in DIAGRAM, 24" in the ground.


From which:

Set a 5/8"x30" iron pins with plastic caps stamped PLS 848 at the following bearings and distances:

- N33°51'W, 25.43 ft., three grooves in top of pin
- N59°31'E, 24.48 ft., no grooves
- S36°05'E, 25.54 ft., one groove in top of pin
- S59°15'W, 23.88 ft., two grooves in top of pin

Measurements to accessories taken with a Wild TC1600 Total Station

This work was performed by:  
Douglas M. Ferguson, PLS 848  
Witnessed by: D. Mitchell Ferguson  
and Brad Cates  
Date: 4-19-98

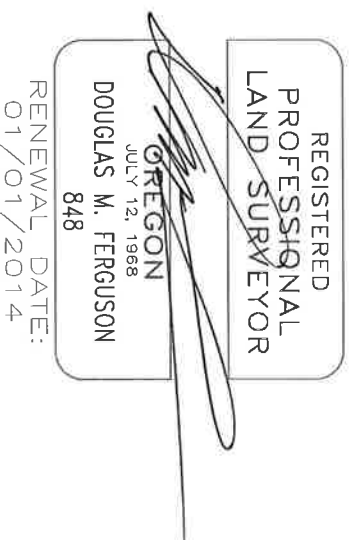

Office of Surveyor, County of Morrow, State of Oregon,  
I hereby certify that the within instrument was  
filed in this office for record on the 23 day of August, 2013

Dale K. Haddock by \_\_\_\_\_  
(COUNTY OFFICIAL) (DEPUTY)

Refer to Morrow County Map No. 2013-34D