


CERTIFIED RECORD OF LAND CORNER MONUMENTATION

U.S.F.S. INDEX No. J-3

History of original corner establishment: This corner was originally established by Zenas F. Moody in 1873, under GLO Contract No. 184.

DIAGRAM

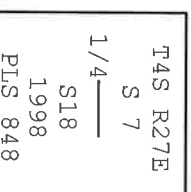

Surveyor General Field Notes State;

Set stone 12x10x8 for 1/4 sec. cor.

Description of Corner Evidence Found:

No original corner evidence found. Set a proportionate measure from the corners 1/2 mile east and 1/2 mile west.

Description of monument and accessories I established to perpetuate the original location of this corner:

At the proportionate position, Set a 2-1/2"x30" aluminum pipe with 2-1/2" aluminum cap, stamped as shown in DIAGRAM, 26" in the ground.

From which:

Set a 5/8"x30" iron pins with plastic caps stamped PLS 848 at the following bearings and distances:

N51°43'W, 21.96 ft., three grooves in top of pin.

N37°33'E, 23.64 ft., no grooves

S51°57'E, 22.69 ft., one groove in top of pin.

S34°54'W, 23.39 ft., two grooves in top of pin.


Measurements to accessories taken with a Wild TC1600 Total Station

This work was performed by:

Douglas M. Ferguson, PLS 848

Witnessed by: D. Mitchell Ferguson
and Brad Cates

Date: 4-20-98

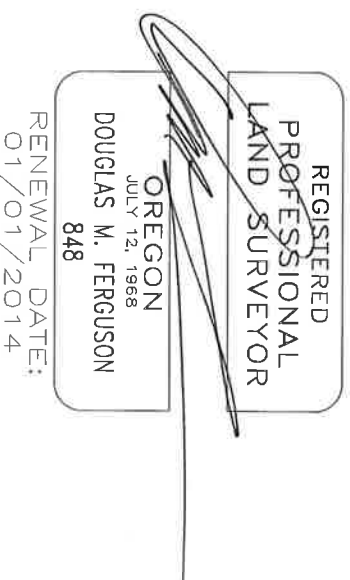

Office of Surveyor, County of Morrow, State of Oregon,
I hereby certify that the within instrument was
filed in this office for record on the 23 day of August, 2013

Shawn K. Haddock by _____
(COUNTY OFFICIAL) (DEPUTY)

Refer to Morrow County Map No. 2013-13D