


CERTIFIED RECORD OF LAND CORNER MONUMENTATION

U.S.F.S. INDEX No. L-5

History of original corner establishment: This corner was originally established by Zenas F. Moody in 1873, under GIO Contract No. 184.

DIAGRAM

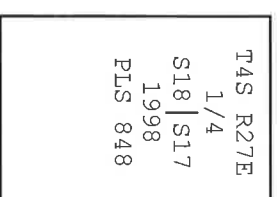

Surveyor General Field Notes State:

Set stone 16x10x4 for 1/4 sec. cor.

Description of Corner Evidence Found:

Found a 4 ft. dia. by 2 ft. high mound of stone with a 12x10x5 stone in the center of the mound. No visible marks on the stone. Accepted as the original corner position.

Description of monument and accessories I established to perpetuate the original location of this corner:

At the center of the mound of stone, Set a 2-1/2"x30" aluminum pipe with 2-1/2" aluminum cap, stamped as shown in DIAGRAM, 4" in the ground, raised a 4.5 ft. dia. by 2.5 ft. high mound of stone.


From which:

Set a 5/8"x30" iron pins with plastic caps stamped PLS 848 at the following bearings and distances:

- N55°45'W, 29.57 ft., no grooves on pin, set in md. of stone.
- N34°12'E, 19.92 ft., one groove in top of pin, set in md. of stone.
- S56°51'E, 26.83 ft., two grooves in top of pin, set in md. of stone.
- S55°05'W, 41.52 ft., three grooves in top of pin, set in md. of stone.

Measurements to accessories taken with a Wild TC1600 Total Station

This work was performed by:
Douglas M. Ferguson, PLS 848
Witnessed by: D. Mitchell Ferguson
and Brad Cates
Date: 4-20-98

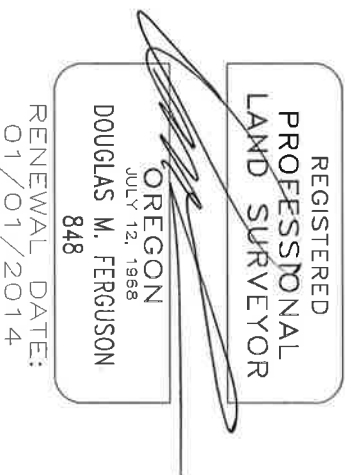

Office of Surveyor, County of Morrow, State of Oregon,
I hereby certify that the within instrument was
filed in this office for record on the 23 day of August, 2013

Debra K. Hubbard by _____
(COUNTY OFFICIAL) (DEPUTY)

Refer to Morrow County Map No. 2013-34D