

OREGON CORNER RESTORATION FORM

COUNTY: Morrow DATE: 01/15/14

CORNER DESIGNATION: X-1, T3S, R27E., The West One-Quarter Corner of Section 31.

PREVIOUS RENEWALS/SURVEYS ETC.: Corner originally established by George Williams, Deputy Surveyor, under Contract No. 176 dated July 20, 1872. Notes state: "Set stone 23 x 7 x 4 for 1/4 sec cor."

MONUMENT AND ACCESSORIES FOUND: 21 x 8 x 5" stone, marked "1/4", lying flat beside small mound of stone, just South of a larger mound of stone.

MONUMENT MARKING DETAIL:

T3S
R26E 1/4 R27E
S36|S31
2014
PLS 1106

MONUMENT SET: At the center of the small stone mound beside the original corner stone, set a 5/8" x 24" iron rebar 20" in the ground to bedrock, with a 2" aluminum cap marked as shown in "Monument Marking Detail". Surrounded corner monument with a 2 1/2' diameter mound of earth and stone.


New accessories set:
A 5/8" x 24" iron rebar with a 1 1/4" red plastic cap marked "OR PLS 1106, WA PLS 17372", bears South 86° East, 79.2 feet. Top of rebar is 12" above ground level, beside a 18" x 18" out of ground loose rock.
A 5/8" x 24" iron rebar with a 1 1/4" red plastic cap marked "OR PLS 1106, WA PLS 17372", bears South 27° East, 53.3 feet. Top of rebar is 6" above ground level. Placed a large rock beside rebar.
A 5/8" x 24" iron rebar with a 1 1/4" red plastic cap marked "OR PLS 1106, WA PLS 17372", bears South 71° West, 39.8 feet. Top of rebar is 4" above ground level. Placed a large rock beside rebar..
A 5/8" x 24 " iron rebar with a 1 1/4" red plastic cap marked "OR PLS 1106, WA PLS 17372", bears North 45° West, 44.4 feet. Top of rebar is 4" above ground level. Placed a large rock beside rebar.
A 3 x 4 x 2' above ground rock bears North 43° East, 150' +/-, (largest rock visible North from corner).
Set steel fence post 3 feet North of corner monument with "Morrow County Witness" sign attached. Sign is visible from the Sanford Canyon Lane South of the Corner.

LOCATION AND COMMENTS: The corner is located on a bare rocky, South facing hillside North of Sanford Canyon Lane.
This corner restoration form is filed in advance of a Land Partition for the Gwendolyn E. Thompson Estate. The recording number for this restoration is noted on said Land Partition Plat.

OREGON STATE PLANE COORDINATE, North Zone, NAD 83(2011)(Epoch 2010.00),
International Feet:
N= 583666.87
E=8455803.72

FIRM: Wells Surveying
P.O. Box 1696
Pendleton, OR 97801

COMPASS DECLINATION: 18° East Surveyor's Seal

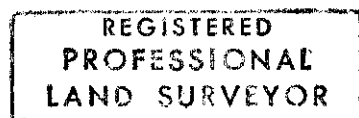

William R. Wells



renews 6-30-14

\T3S27MorrowX1

RECEIVED BY
Morrow County Surveyor
Date: 2-20-14
Rec'd By: S.K.H.
No.: 35 27 X1
Folder No.: _____