

OREGON CORNER RESTORATION FORM

Section 18 Township 3S Range 29E
County Morrow Date: July 22, 2005

Corner Designation: 3S29J1

Condition Report Only
Not found _____
Remonumented x
Unrecorded _____
Surveyed in _____
Referenced out x

Corner to sections 12 and 13 R28E, and 7 and 18, R29E, T3S, W.M., Morrow County, Oregon.


Previous Renewals / Surveys, etc.

Corner originally set by George Williams under contract No. 176 dated July 20, 1872. His record reads: Set stone 16 x 8 x 6 for corner to secs. 12, 13, 7, 18.


Monument and Accessories found: (condition and source)

I found the original stone plainly notched and firmly in place with approximately 6" showing above the ground.

DIAGRAM

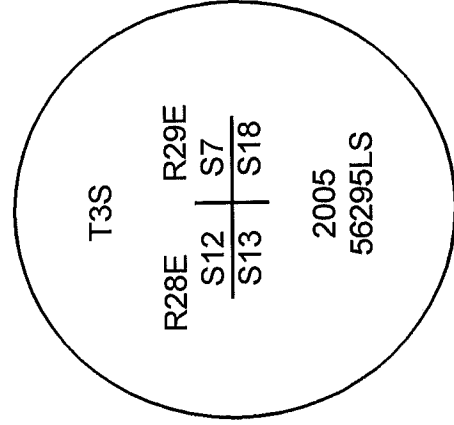

SKETCH

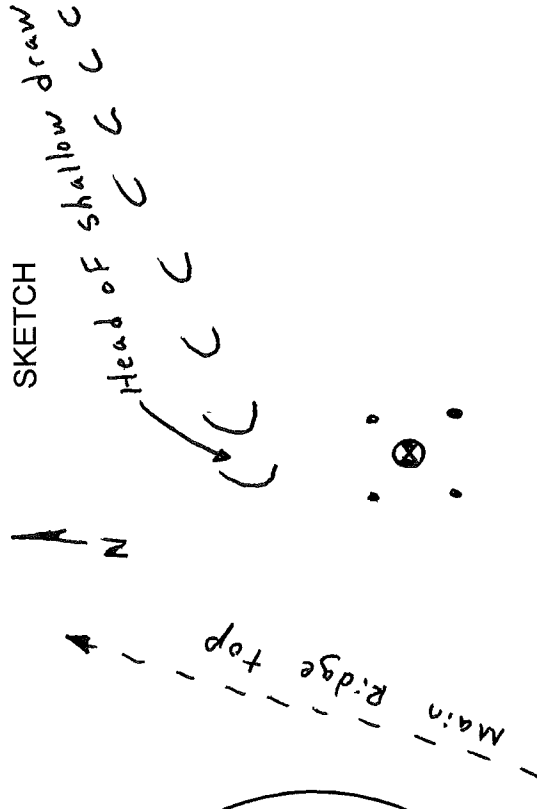

MONUMENT (S) AND ACCESSORIES SET (Procedures and Description)

Set a 1 1/2" x 30" galvanized iron pipe with a 2 1/4" brass cap stamped as shown in the diagram above at the position of the original stone. I buried the original stone on the north side of the pipe and built a mound of stone 3' diameter and 2' high on the east side of the monument.

For references, I set four, 5/8" by 24" rebars with 1 1/8" orange plastic caps stamped WTS and 56295LS as described below:

- an iron rebar bears N26°17'48"E, 24.26 feet;
- an iron rebar bears N48°11'04"W, 29.87 feet;
- an iron rebar bears S43°39'51"W, 23.85 feet;
- an iron rebar bears S55°56'10"E, 26.23 feet;

The monument and references were tied using a Trimble R7/R8 RTK GPS.

Location and comments

Compass Declination

Surveyors Seal

RECEIVED BY:

Morrow County Surveyor
Date: AUG 30, 2005
Rec'd By: SKB
No. _____

Firm / Agency
Witness Tree Surveying
Address
P.O. Box G
Pilot Rock, Or. 97868
Party Chief
Stephen K, Haddock



Stephen K. Haddock

