

OREGON CORNER RESTORATION FORM

Section 19 Township 3S Range 29E
 County Morrow Date: July 22, 2005

Corner Designation: 3S29N1

Condition Report Only
 Not found _____
 Remonumented x
 Unrecorded _____
 Surveyed in _____
 Referenced out x


Corner to sections 13 and 24 R28E, and 18 and 19, R29E,
 T3S, W.M., Morrow County, Oregon.

Previous Renewals / Surveys, etc.

Corner originally set by George Williams under contract No. 176 dated July 20, 1872. His record reads: Set stone 24 x 9 x 3 for corner to secs. 13, 24, 18, 19.

Monument and Accessories found: (condition and source)
 I found the original stone notched and firmly in place with approximately 9" showing above the ground. A wedge of stone 2"x1"x6" of the north edge of the stone had been broken off.

DIAGRAM

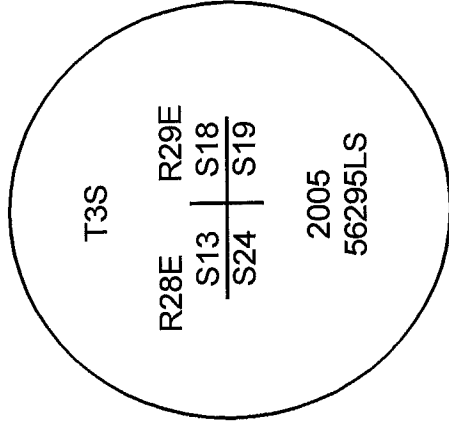

SKETCH

MONUMENT (S) AND ACCESSORIES SET (Procedures and Description)

Set a 1 1/2" x 30" galvanized iron pipe with a 2 1/4" brass cap stamped as shown in the diagram above at the position of the original stone. I buried the original stone along side of the pipe and built a mound of stone 3' diameter and 3' high on the east side of the monument.

For references, I set four, 5/8" by 24" rebars with 1 1/8" orange plastic caps stamped WTS and 56295LS as described below:

- an iron rebar bears N40°08'24"E, 25.48 feet;
- an iron rebar bears N45°05'20"W, 42.27 feet;
- an iron rebar bears S55°30'47"W, 28.92 feet;
- an iron rebar bears S32°52'47"E, 22.58 feet;

The monument and references were tied using a Trimble R7/R8 RTK GPS.

Location and comments Compass Declination Surveyors Seal

RECEIVED BY:
Morrow County Surveyor
 Date: Aug 30, 2005
 Rec'd By: SKB
 No. _____

Firm / Agency
 Witness Tree Surveying
 Address
 P.O. Box G
 Pilot Rock, Or. 97868
 Party Chief
 Stephen K, Haddock

**REGISTERED
 PROFESSIONAL
 LAND SURVEYOR**

Stephen K. Haddock

OREGON
 JULY 9, 2001
 STEPHEN K. HADDOCK
 56295LS

RENEWAL DATE **6-30-07**