

OREGON CORNER RESTORATION FORM

Section 36 Township 3S Range 28E
 County Morrow Date: 23-Aug-21

Corner Designation: 3S28Z21

Condition report only
 Not Found
 Remonumented
 Unrecorded
 Surveyed In
 Referenced Out


South corner to Sections 35 and 36, T3S, R28E, W.M.,
 Morrow County, Oregon.

Previous Renewals, Surveys, etc...

This corner was originally set by George Williams under Contract No. 176, Dated July 20th, 1872. His record reads: Set a stone 20x9x5 for corner to Sections 35, 36, 1, 2. No trees in sight. Frank W. Campbell under his contract No. 507 dated June 28th, 1884 changed this corner to apply to Township 3 South, Range 28 East only citing "The established corner to Sec's 35 & 36, T3S, R28E". On September 11, 1922, under Morrow County Survey 2017-1265A, James Kirschner found the original stone at the corner of a rock jack 3.75 chains west of the corner to sections 1 & 2, T4S, R28E. His record reads "find rock crib, also original stone lying loose on ground and broken". He renewed the corner by setting a stone 10x19x24 mkd with 6 notches on E&W faces and north edge and CS on west face. Build mound of stone around corner.

Monument and accessories found: (condition and source)

Found a basalt stone 24x19x10 inches marked as described by Kirschner in a mound of stone 247.83' west of the corner to sections 1 & 2, T4S, R28E.

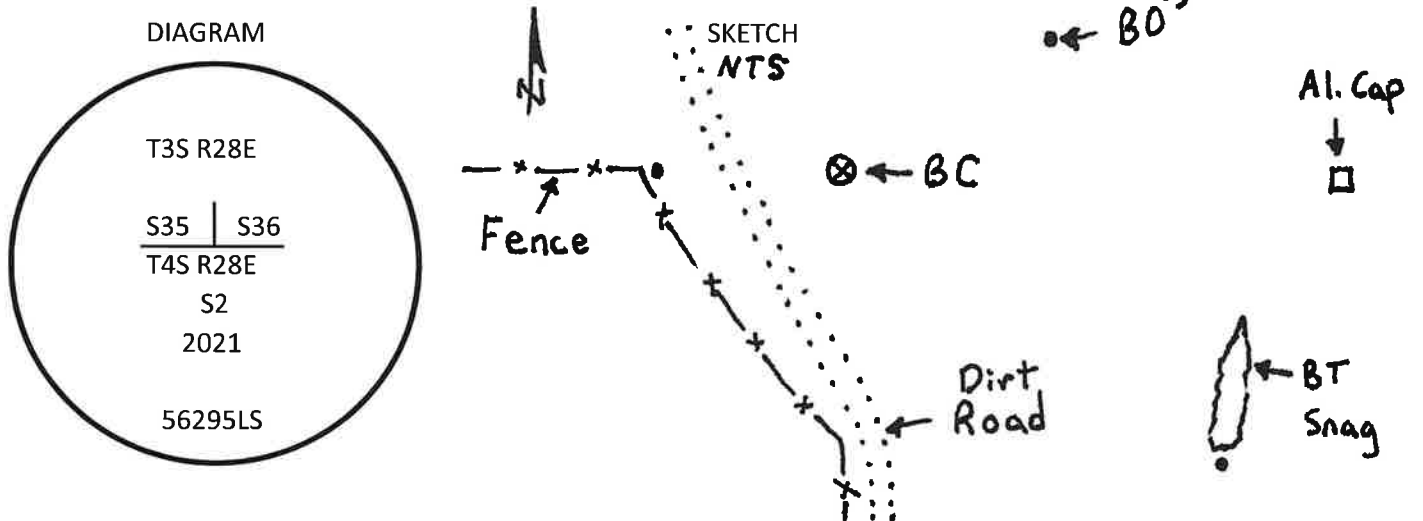

MONUMENT(S) AND ACCESSORIES SET (Procedures and Description)

At the position of the Kirschner's stone I set a 2 1/2" brass cap on a 2 1/2" x 30" galvanized iron pipe 28" in the ground. Kirschner's stone was buried upside down along the SE side of the cap.

For references I set three 5/8" by 24" iron rebars with 1.25" orange plastic caps stamped WTS and 56295LS as described below:

- An iron rebar bears S88°07'33"W 86.34 feet at a corner in the fence with fences west and southeast;
- An iron rebar bears S53°29'41"E 197.65 feet in the root hole for the BT to the corner to Sections 1 & 2;
- An iron rebar bears N26°25'13"E 150.62 feet;
- A 1" iron rebar w/2" al cap at the corner to T4S, R28E, Sections 1 and 2 bears S89°54'13"E 247.83 feet;

Measurements were made with a Trimble R8S base/rover RTK GPS system.

Location and comments:

Approximate coordinate WGS84

Latitude = 45°15'19.66"N

Longitude = 119°17'26.99"W

RECEIVED BY:

Morrow County Surveyor

Date: 10-4-21

Rec'd By: MPK

No. 3S28Z21

SURVEY REF: 2021-1957D

Compass Declination

Firm / Agency

Witness Tree Surveying

Address

P.O. Box G

Pilot Rock, OR 97868

Party Chief

Stephen K. Haddock

Surveyor's Seal

REGISTERED
 PROFESSIONAL
 LAND SURVEYOR

Stephen K. Haddock

OREGON
 JULY 9, 2001
 STEPHEN K. HADDOCK
 56295LS

RENEWS: 6-30-23