

OREGON CORNER RESTORATION FORM

Section 18 Township 3S Range 29E
 County Morrow Date: July 26, 2005

Corner Designation: 3S29L5

Condition Report Only
 Not found _____
 Remonumented x
 Unrecorded _____
 Surveyed in _____
 Referenced out x


Quarter corner to sections 17 and 18, T3S, R29E, W.M. Morrow County, Oregon.

Previous Renewals / Surveys, etc.

The corner was originally set by George Williams under contract No. 176 dated July 20, 1872. His record reads: Set stone 22x12x8 for 1/4 sec cor.

Monument and Accessories found: (condition and source)

I found the original stone plainly marked 1/4 firmly set in the ground with about 8" showing above the ground.

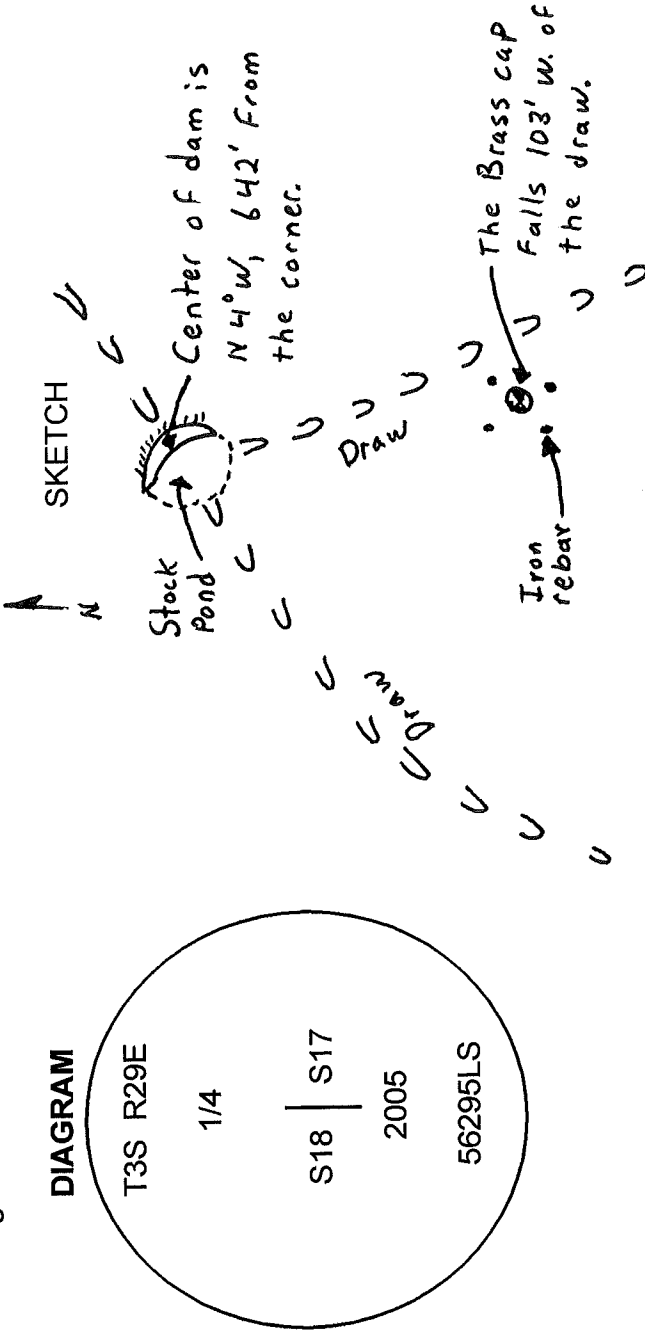

MONUMENT (S) AND ACCESSORIES SET (Procedures and Description)

I set a 1 1/4" x 30" Galvanized Iron Pipe with a 2 1/2" brass cap stamped as shown in the diagram above 30" in the ground. I built a mound of stone and earth 18" diameter by 12" high about 2 feet north of the brass cap. There was no other stone in this area. For references I set four 5/8" x 24" iron rebars with 1 1/8" orange plastic caps stamped WTS and 56295LS as described below:
 an iron rebar bears N40°17'03"E, 23.67 feet;
 an iron rebar bears N46°28'57"W, 25.94 feet;
 an iron rebar bears S50°38'39"W, 40.25 feet;
 an iron rebar bears S42°27'49"E, 42.07 feet;

These references were set and tied using a Trimble R7/R8 RTK GPS

Location and comments

Compass Declination

Surveyors Seal

RECEIVED BY:
 Morrow County Surveyor
 Date: Aug 30, 2005
 Rec'd By: SKB
 No. _____

Firm / Agency
 Witness Tree Surveying
 Address
 P.O. Box G
 Pilot Rock, Or. 97868
 Party Chief
 Stephen K, Haddock

REGISTERED
 PROFESSIONAL
 LAND SURVEYOR

Stephen K. Haddock

OREGON
 JULY 9, 2001
 STEPHEN K. HADDOCK
 56295LS

RENEWAL DATE 6-30-07