

OREGON CORNER RESTORATION FORM

Section 19 Township 3S Range 29E
County Morrow Date: July 26, 2005

Corner Designation: 3S29P5

Condition Report Only
Not found _____
Remonumented _____
Unrecorded _____
Surveyed in _____
Referenced out x

Quarter corner to sections 19 and 20, T3S, R29E, W.M. Morrow County, Oregon.


Previous Renewals / Surveys, etc.

The corner was originally set by George Williams under contract No. 176 dated July 20, 1872. His record reads: Set stone 18x10x4 for 1/4 sec cor.


Monument and Accessories found: (condition and source)

I found the original stone plainly marked 1/4 set in a circular mound of stone with about 8" showing above the ground.

DIAGRAM

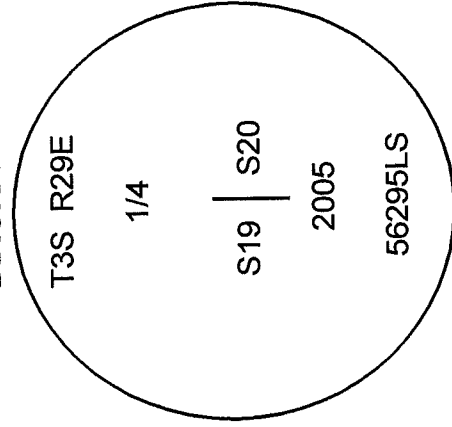

SKETCH

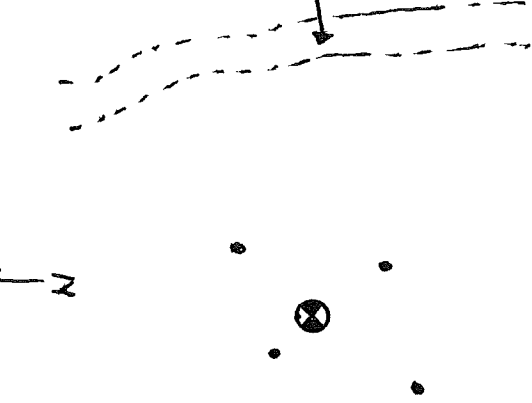

MONUMENT (S) AND ACCESSORIES SET (Procedures and Description)

I set a 2 1/2" brass cap on a 2 1/2" x 12" stainless steel pipe with a magnetic insert. The cap was stamped as shown in the diagram above. The cap was set to bedrock. I raised a mound of stone and earth 3 feet in diameter to the top of the cap.

For references I set four 5/8" x 24" iron rebars with 1 1/8" orange plastic caps stamped WTS and 56295LS as described below:

- an iron rebar bears N43°09'52"E, 61.35 feet;
- an iron rebar bears N51°03'09"W, 31.03 feet;
- an iron rebar bears S42°18'51"W, 93.22 feet;
- an iron rebar bears S06°17'26"E, 69.68 feet;

These references were set and tied using a Trimble R7/R8 RTK GPS

Location and comments

Compass Declination

Surveyors Seal

RECEIVED BY:
Morrow County Surveyor
Date: Aug 30, 2005
Rec'd By: S.K.B
No. _____

Firm / Agency
Witness Tree Surveying
Address
P.O. Box G
Pilot Rock, Or. 97868
Party Chief
Stephen K, Haddock

REGISTERED
PROFESSIONAL
LAND SURVEYOR

Stephen K. Haddock

OREGON
JULY 9, 2001
STEPHEN K. HADDOCK
56295LS

RENEWAL DATE 6-30-07