

OREGON CORNER RESTORATION FORM

Section 29 Township 3S Range 29E
County Morrow Date: August 2, 2005

Corner Designation: 3S29T7

Center 1/4 corner to Section 29, T3S, R29E W.M.
Morrow County, Oregon.


Condition Report Only
Not found
Remonumented
Unrecorded
Surveyed in x
Referenced out x

Previous Renewals / Surveys, etc.

There has been no previous establishment of a monument at this corner point.

Monument and Accessories found: (condition and source)
None.

DIAGRAM

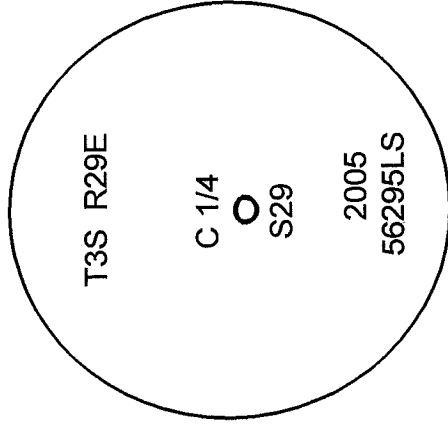

SKETCH

MONUMENT (S) AND ACCESSORIES SET (Procedures and Description)

I set a 1" x 24" iron rebar with a 2" aluminum Cap stamped as shown above flush with the surface of the ground at the calculated center 1/4 location.

For references, I set four 5/8" by 24" iron rebars with 1 1/8" orange plastic caps stamped WTS and 56295LS as described below:
a rebar bears N23°03'20"E, 43.35 feet;
a rebar bears N39°48'52"W, 24.00 feet;
a rebar bears S34°53'06"W, 59.08 feet;
a rebar bears S36°12'41"E, 70.77 feet;

The monument was set and references tied using a Trimble R7/R8 RTK GPS.

Location and comments

Compass Declination

Surveyors Seal

RECEIVED BY:

Morrow County Surveyor
Date: Aug 30, 2005
Rec'd By: SKB
No. _____

Firm / Agency
Witness Tree Surveying
Address
P.O. Box G
Pilot Rock, Or. 97868
Party Chief
Stephen K, Haddock



Stephen K. Haddock

