

OREGON CORNER RESTORATION FORM

Section 32 Township 3S Range 29E
County Morrow Date: July 22, 2005

Corner Designation: 3S29V5

Corner to sections 29, 30, 31, and 32, T3S, R29E,
W.M., Morrow County, Oregon.


Previous Renewals / Surveys, etc.

Corner originally set by George Williams under contract No. 176 dated July 20, 1872. His record reads: Set stone, 20 x 9 x 6 for cor. to secs. 29, 30, 31, 32 on hill side.

Monument and Accessories found: (condition and source)
The original stone, slightly tipped but firmly in place as described.

Condition Report Only
Not found _____
Remonumented x
Unrecorded _____
Surveyed in _____
Referenced out x

DIAGRAM

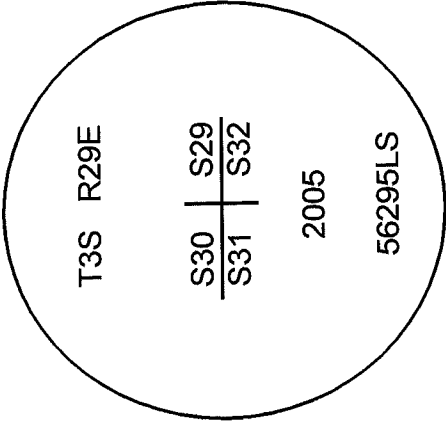

SKETCH

MONUMENT (S) AND ACCESSORIES SET (Procedures and Description)
I set a 1 1/2" x 30" galvanized iron pipe with a 2 1/4" brass cap stamped as shown in the diagram above at the position of the original stone 20" in the ground to bedrock. I built a mound of earth and stone 2' diameter and 1' high around the pipe and buried the original stone along side.

For references, I set four, 5/8" by 24" rebars with 1 1/8" orange plastic caps attached, stamped WTS and 56295LS as described below:
an iron rebar bears N40°58'39"E, 27.03 feet;
an iron rebar bears N28°12'36"W, 47.05 feet;
an iron rebar bears S27°17'54"W, 64.37 feet;
an iron rebar bears S86°10'05"E, 81.36 feet;

The monument and references were tied using a Trimble R7/R8 RTK GPS.

Location and comments

Compass Declination

Surveyors Seal

RECEIVED BY:
Morrow County Surveyor
Date: AUG 30, 2005
Rec'd By: SKB
No. _____

Firm / Agency
Witness Tree Surveying
Address
P.O. Box G
Pilot Rock, Or. 97868
Party Chief
Stephen K, Haddock



Stephen K. Haddock

