

OREGON CORNER RESTORATION FORM

Section 32 Township 3S Range 29E
County Morrow Date: July 25, 2005

Corner Designation: 3S29V9



Condition Report Only
Not found _____
Remonumented x
Unrecorded _____
Surveyed in _____
Referenced out x

Corner to sections 28, 29, 32, and 33, T3S, R29E, W.M., Morrow County, Oregon.

Previous Renewals / Surveys, etc.

Corner originally set by George Williams under contract No. 176 dated July 20, 1872. His record reads: Set stone, 20 x 9 x 6 for cor. to secs. 28, 29, 32, 33 on West hill side.

Monument and Accessories found: (condition and source)
The original stone, plainly chisled and firmly in place as described.

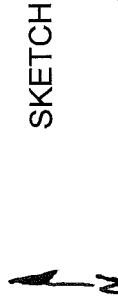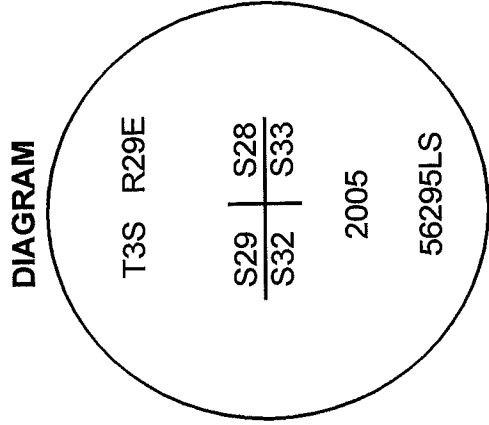

⊙ = Brass Cap
• = Iron Rebar

MONUMENT (S) AND ACCESSORIES SET (Procedures and Description)

I set a 1 1/2" x 30" galvanized iron pipe with a 2 1/4" brass cap stamped as shown in the diagram above at the position of the original stone 20" in the ground to bedrock. I built a mound of earth and stone around the monument and buried the original stone on the south side of the pipe.

For references, I set four, 5/8" by 24" rebars with 1 1/8" orange plastic caps attached, stamped WTS and 56295LS as described below:
an iron rebar bears N30°15'17"E, 27.61 feet;
an iron rebar bears N38°33'52"W, 32.66 feet;
an iron rebar bears S16°00'16"W, 39.97 feet;
an iron rebar bears S38°18'47"E, 68.69 feet;

The monument and references were tied using a Trimble R7/R8 RTK GPS.

Location and comments

Compass Declination

Surveyors Seal

RECEIVED BY:
Morrow County Surveyor
Date: AUG 30 2005
Rec'd By: SKB
No. _____

Firm / Agency
Witness Tree Surveying
Address
P.O. Box G
Pilot Rock, Or. 97868
Party Chief
Stephen K, Haddock

REGISTERED
PROFESSIONAL
LAND SURVEYOR

Stephen K. Haddock
OREGON
JULY 9, 2001
STEPHEN K. HADDOCK
56295LS

RENEWAL DATE 6-30-07