

OREGON CORNER RESTORATION FORM

Section 32 Township 3S Range 29E
County Morrow Date: August 2, 2005

Corner Designation: 3S29X7

Center 1/4 corner to section 32, T3S, R29E W.M.
Morrow County, Oregon.


Condition Report Only
Not found
Remonumented
Unrecorded
Unsurveyed in
Referenced out

Previous Renewals / Surveys, etc.

There has been no previous establishment of a monument at this corner point.


Monument and Accessories found: (condition and source)
None.

DIAGRAM

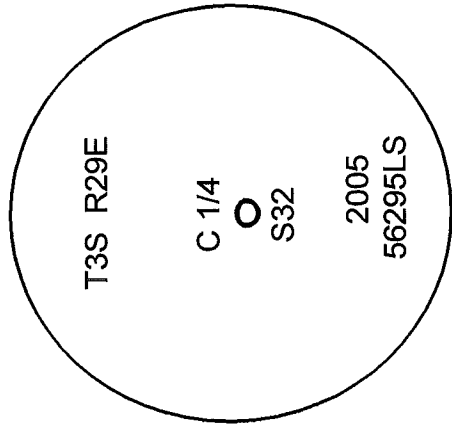

⊗ = Brass Cap
• = Iron Rebar

SKETCH

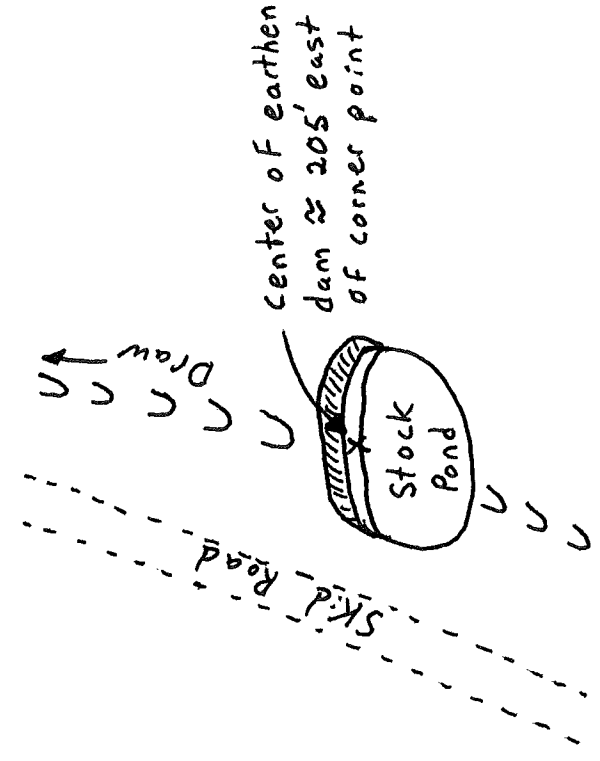

MONUMENT (S) AND ACCESSORIES SET (Procedures and Description)

I set a 1" x 24" iron rebar with a 2" aluminum Cap stamped as shown above flush with the surface of the ground at the calculated center 1/4 location.

For references, I set four 5/8" by 24" iron rebars with 1 1/8" orange plastic caps stamped WTS and 56295LS as described below:
a rebar bears N73°39'58"E, 45.68 feet;
a rebar bears N21°40'04"W, 28.19 feet;
a rebar bears S23°31'43"E, 32.01 feet;
a rebar bears S77°47'51"W, 36.46 feet;

The monument was set and references tied using a Trimble 5601 Robotic Total Station.

Location and comments

Compass Declination

Surveyors Seal

RECEIVED BY:

Morrow County Surveyor
Date: Aug 30, 2005
Rec'd By: SKB
No. _____

Firm / Agency
Witness Tree Surveying
Address
P.O. Box G
Pilot Rock, Or. 97868
Party Chief
Stephen K, Haddock

REGISTERED
PROFESSIONAL
LAND SURVEYOR

Stephen K. Haddock

OREGON
JULY 9, 2001
STEPHEN K. HADDOCK
56295LS

RENEWAL DATE 6-30-07