

CERTIFIED RECORD OF LAND CORNER MONUMENTATION

Z - 23 T3S, R29E
 DIAGRAM

T3S R29E
<u>1/4 S36</u>
T4S
PLS 1636
2000

History of original corner establishment:

The original corner was established by George Williams on September 18, 1872, under GLO contract No. 176, as follows:

Set stone, 19" x 8" x 4", for 1/4 section corner, from which:

- A 30" pine bears S78°E, 623 links (411.18 feet).
- A 12" pine bears N51°E, 205 links (135.3 feet).

This corner was described by Edward W. Sanderson in his retracement survey on August 10, 1882, under GLO contract No. 417, as follows:

A basalt stone, 10" x 6" x 6" above the ground, firmly set in ground, the 1/4 section corner, marked 1/4 on west face. Mound of stone around same.

Original corner evidence found:

The corner stone is gone. The corner point falls in a logging landing area, which has been badly disturbed.

A live 38" Ponderosa Pine with a previously opened blaze with scribes visible, bears S77°E, 411.2 feet. I nail a "Bearing Tree" sign above the blaze.

A sawn and decayed Ponderosa Pine stump, no marks remaining, bears N51°E, 135.3 feet.

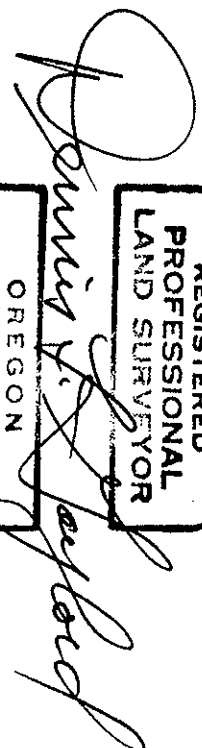
Monument and accessories established to perpetuate the original position of this corner:

At record distance from the bearing tree evidence, I set a 1" x 30" galvanized iron pipe 24" into the ground. A 2 1/2" brass cap attached to the pipe is marked as shown in the diagram above. I build a mound of stones around the pipe, from which:

- A 15" Ponderosa Pine, scribed "1/4 S36 BT" on double blazes, bears N24°E, 98.0 feet.
- A 7" Ponderosa Pine, scribed "T4S BT" on double blazes, bears S34°W, 140.8 feet.
- A 17" Ponderosa Pine, scribed "1/4 S36 BT" on double blazes, bears N20°W, 57.1 feet.

The new bearing trees each have a 3/4" brass washer, marked "PLS 1636", nailed flush to the scribed "B".

I hereby certify the above corner point was perpetuated as hereon described on July 28, 2000. Magnetic declination set in compass: 18°E.

REGISTERED PROFESSIONAL LAND SURVEYOR

 OREGON
 JULY 14 1978
 DENNIS L. GAYLORD
 1636

Renews June 30, 2001

Recorded at the office of County Surveyor, County of Morrow, State of Oregon, on: