


**History of original corner establishment:**

This corner was originally established by John B. David under G.L.O. contract No. 131, dated June 8, 1869. Survey General notes state:

Set stone 15x7x6 for 1/4 sec. corner.

Corner re-monumented in 1961 by Verl Fraley, Morrow County Map of Survey C-198-K. Plat states:

"Fd spike replaced with I.R."

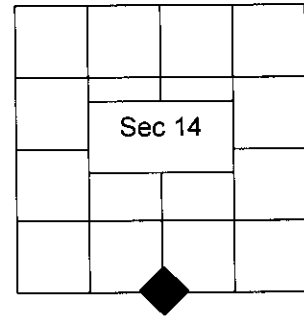

**Description of corner evidence found:**

We recover the iron rod set by Fraley, Map of Survey C-198-K

**Description of monument and accessories I establish to perpetuate the original location of this corner:**

At the position of the said iron rod, set a 2-1/2" dia. x 30" steel pipe monument w/3" dia. brass cap stamped as shown in the DIAGRAM, 5" below the road grade, in a cast iron monument box, from which:

- A 5/8" iron pin bears N00°13'01"W, 20.00 ft., R/W pin Sta. 57+71.94, 20' Lt.
- A 5/8" iron pin bears S00°13'01"E, 30.00 ft., R/W pin Sta. 57+71.94, 30' Rt.

**DIAGRAM**

T4N R24E  
S14  
1/4----  
S23  
2009  
PLS 49865

Measurements to accessories taken with Topcon Hyper Lite GPS.

I hereby certify that the above corner point was perpetuated as shown hereon in March, 2009

Witness: D. Mitchell Ferguson, LSIT  
David H. Herburger, Surv. Tech.

Office of County Surveyor \_\_\_\_\_ County of Morrow  
State of Oregon. I hereby certify that the within instrument was filed in this office  
for record on the 16<sup>th</sup> day of April, 2014

Stephen K. Hallock by \_\_\_\_\_  
County Surveyor Deputy

See Morrow County Map of Survey No. 2013-38D(1685)

REGISTERED  
PROFESSIONAL  
LAND SURVEYOR

OREGON  
JULY 13, 1999  
KENNETH H. DELANO JR.  
49865  
RENEWS: 1/1/2016