

CERTIFIED RECORD OF LAND CORNER MONUMENTATION

T.4N., R.24E., INDEX N-21

History of original corner establishment:


This corner was originally established by John B. David under G.L.O. contract No. 131, dated June 8, 1869. Survey General notes state:

Set post in mound for cor to secs 13, 14, 23 & 24.

Corner re-monumented in 1961 by Verl Fraley, Morrow County Map of Survey C-198-K. Plat states:

"Set 1/2" I.R."

In 1982, Dave Krumbein replace Fraley's iron rod with a Brass Cap. See Map of Survey C-527-K

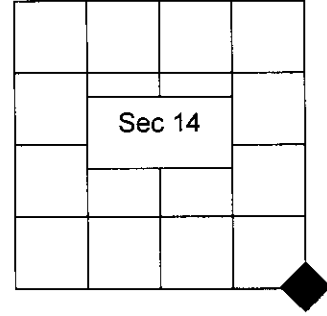

Description of corner evidence found:

We recover the brass cap set by Krubein, Map of Survey C-527-K

Description of monument and accessories I establish to perpetuate the original location of this corner:

At the position of the said brass cap, set a 2-1/2" dia. x 30" steel pipe monument w/3" dia. brass cap stamped as shown in the DIAGRAM, 5" below the road grade, in a cast iron monument box, from which:

- A 1/2" iron rod bears N45°29'32"W, 28.47 ft.
- A 5/8" iron pin bears N44°17'22"E, 28.37 ft., R/W pin Sta. 84+59.73, 20' Lt.
- A 5/8" iron pin bears S34°04'16"E, 35.85 ft., R/W pin Sta. 84+59.25, 30' Rt.
- A 5/8" iron pin bears S33°14'46"W, 35.96 ft., R/W pin Sta. 84+19.79, 30' Rt.

DIAGRAM

T4N R24E
S14|S13

S23|S24
2009
PLS 49865

Measurements to accessories taken with Topcon Hyper Lite GPS.

I hereby certify that the above corner point was perpetuated as shown hereon in March, 2009

Witness: D. Mitchell Ferguson, LSIT
David H. Herburger, Surv. Tech.

Office of County Surveyor _____ County of Morrow
State of Oregon. I hereby certify that the within instrument was filed in this office
for record on the 16th day of April, 2014

Stephen K. Haddock by _____
County Surveyor Deputy

See Morrow County Map of Survey No. 2013-38D(1685)

REGISTERED
PROFESSIONAL
LAND SURVEYOR

OREGON
JULY 13, 1999
KENNETH H. DELANO JR.
49865
RENEWS: 1/1/2016