

CERTIFIED RECORD OF LAND CORNER MONUMENTATION

T.4N., R.24E., INDEX N-25


History of original corner establishment:

This corner was originally established by John B. David under G.L.O. contract No. 131, dated June 8, 1869. Survey General notes state:

Set stone 19x12x5 for cor to secs 7, 12, 13 & 18

Corner re-monumented by Dennis Edwards in 1993. Referring to Morrow County Map of Survey C-1230-E. Plat states:

"FND 1 3/8" BC SET IN PLACE OF 5/8" I. REBAR, ME 1993"

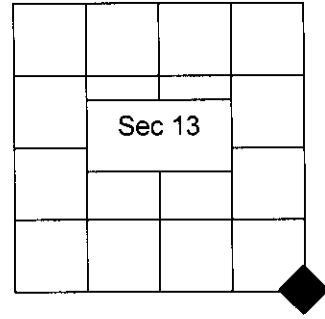

Description of corner evidence found:

We recover brass cap set by Edwards in 1993. Refer to Map of Survey C-1230-E.

Description of monument and accessories I establish to perpetuate the original location of this corner:

At the position of the said brass cap, set a 2-1/2" dia. x 30" steel pipe monument w/3" dia. brass cap stamped as shown in the DIAGRAM, 5" below the road grade, in a cast iron monument box, from which:

- A 5/8" iron pin bears N44°57'02"W, 27.81 ft., R/W pin Sta. 137+57.81, 20' Lt.
- A 5/8" iron pin bears N45°44'22"E, 28.42 ft., R/W pin Sta. 137+97.32, 20' Lt.
- A 5/8" iron pin bears S33°51'29"E, 36.33 ft., R/W pin Sta. 137+97.63, 30' Rt.
- A 5/8" iron pin bears S33°05'20"W, 36.19 ft., R/W pin Sta. 137+56.89, 30' Rt.

DIAGRAM

T4N
R24E R25E
S13|S18

S24|S19
2009
PLS 49865

Measurements to accessories taken with Topcon Hyper Lite GPS.

I hereby certify that the above corner point was perpetuated as shown hereon in March, 2009

Witness: D. Mitchell Ferguson, LSIT
David H. Herburger, Surv. Tech.

Office of County Surveyor County of Morrow
State of Oregon. I hereby certify that the within instrument was filed in this office
for record on the 16th day of April, 2014

Steph K. Hubbard by _____
County Surveyor Deputy

See Morrow County Map of Survey No. 2013-38D(1685)

REGISTERED
PROFESSIONAL
LAND SURVEYOR

OREGON
JULY 13, 1999
KENNETH H. DELANO JR.
49865
RENEWS: 1/1/2016