

Record of Land Corner Monumentation

Sections 1 & 12 Township 4N Range 25E Code T4N R25E E25

County Morrow Date September 17, 2015

History of Original Corner Establishment:

The corner was first established in 1869 by J. B. David in Original GLO Survey of Township 4 North, Range, 26 East under Contract No. 131.
Record Reads: Set Post in Mound for Corner to Townships 4N, Range 25 & 26 E.
O. O. Gould completed a Dependent Resurvey in 1939.
Record Reads: Found 30" x 3" square Wooden Post, Set Brass Cap on 2" x 36" Iron Post.
In 1986 Krumbein set a 2 3/8" Brass Cap on 1 1/2" x 30" Iron Pipe below ground under Morrow County Survey C-827-K.

Description of evidence found:



Found 2 3/8" Brass Cap on 1 1/2" x 30" Iron Pipe buried in ground & Set by Krumbein under Morrow County Survey C-827-K. The Brass Cap fell in the center of alignment for a Proposed Roadway and would be Destroyed by Construction.

Description of monumentation and accessories established to perpetuate the location of this Section Corner:

I Referenced the Monument Set by Krumbein Prior to Construction. The Monument was Destroyed by Construction before I could remove it. After Construction I Reset a New Monument, 2 1/2" Brass Cap on 1 1/2" x 30" Iron Pipe, at the Referenced Corner Location inside an Aluminum Monument Box in the Center Line of Completed Road, Lewis & Clark Drive.

In addition, the following Bearing Objects were Tagged with Bearing Object Placards and a Washer Stamped PLS 2431 as follows, or as described:
All Bearings & Distances are to the Center of the Washer, Plastic Cap, or Bolt as Described.

- 1 - A 5/8" Rebar w/Plastic Cap #2431 bears N 0° 37' 20" W 50.00 feet.
 - 2 - A Steel Pole for Street Light bears N 75° 41' 43" E 118.95 feet.
 - 3 - A Steel Power Tower bears S 72° 47' 43" E 123.86 feet.
Bolt on Tower Base tagged with #2431 washer.
 - 4 - A Steel Pole for Street Light bears S 73° 26' 00" W 119.95 feet.
- All directions on placards are given to the set monument.

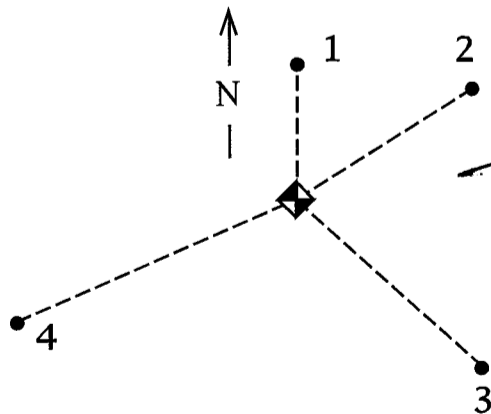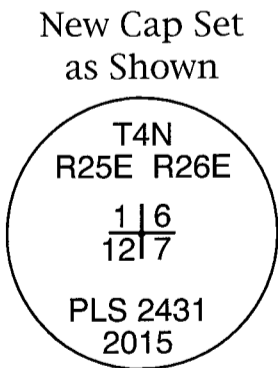

Expires 12-31-16

Office of County of Morrow
 State of Oregon I hereby certify that the within instrument was
 filed in this office for record on the 22 day of October, 2015
 County Surveyor by: Elyse K. Adcock
 (COUNTY OFFICIAL) (DEPUTY)

Survey Number 4N 25E 25