

CERTIFIED RECORD OF LAND CORNER MONUMENTATION

COUNTY: MORROW


DATE: JUNE 11, 2021

CORNER DESIGNATION: J-13, SECTION CORNER COMMON TO SECTIONS 9/10/15/16, T 4N, R 25E, W.M.

J-13  
T. 4N, R. 25E, W.M.

HISTORY OF ORIGINAL CORNER ESTABLISHMENT:

A 5/8" IRON ROD MARKED "PARAMETRIX" WAS FOUND PER MORROW COUNTY SURVEY NO. 2018-1839C. THERE IS A DETAILED NARRATIVE ON SAID SURVEY FOR THE LOCATION OF THIS CORNER.

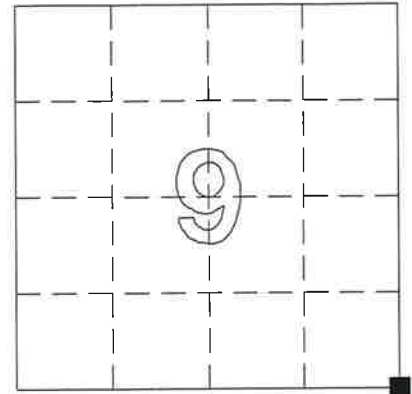


DESCRIPTION OF MONUMENT FOUND:

A 5/8" IRON ROD WITH YELLOW PLASTIC CAP MARKED "PARAMETRIX" PER MORROW COUNTY SURVEY NO. 2018-1839C WAS FOUND PRIOR TO ROAD CONSTRUCTION. A 1/2" COPPER CAP MARKED AS SHOWN BELOW ON 5/8" X 30" COPPER CLAD ROD WAS SET AFTER CONSTRUCTION IN SAME LOCATION.

DESCRIPTION OF ACCESSORIES ESTABLISHED:

NEW ACCESSORIES:

- A 5/8"x30" IRON ROD WITH ALUMINUM CAP, MARKED "APA RM 49593PLS", BEARS N56°25'42"W, 24.14'
- A 5/8"x30" IRON ROD WITH ALUMINUM CAP, MARKED "APA RM 49593PLS", BEARS N48°35'29"E, 22.90'
- A 5/8"x30" IRON ROD WITH ALUMINUM CAP, MARKED "APA RM 49593PLS", BEARS S65°07'26"E, 19.33'
- A 5/8" IRON ROD WITH YELLOW PLASTIC CAP, MARKED "PARAMETRIX", BEARS S86°45'21"W, 19.93'

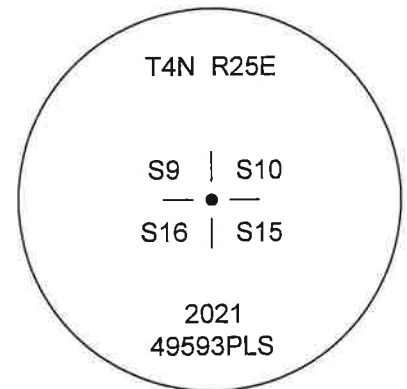

SPCS OREGON NORTH (International Feet)

Northing: 781744.19  
Easting: 8409773.45

WITNESSES:

- RYAN HAYS, SURVEY PARTY CHIEF
- SAM SILVEIRA, SURVEY TECHNICIAN

REGISTERED  
PROFESSIONAL  
LAND SURVEYOR

OREGON  
FEBRUARY 8, 2000  
RICHARD E. STEIN  
49593PLS

RENEWAL DATE: 06/30/2022

**ap** anderson  
perry  
& associates, inc.

ANDERSON PERRY & ASSOCIATES, INC.  
1901 N. FIR STREET  
LA GRANDE, OR 97850  
(541) 963-8309

8-9-21 BY:MPK NO: 4N25T13