

CERTIFIED RECORD OF LAND CORNER MONUMENTATION

COUNTY: MORROW


DATE: JUNE 11, 2021

CORNER DESIGNATION: K-13, NORTH 1/16 CORNER COMMON TO SECTIONS 15/16, T 4N, R 25E, W.M.

K-13
T. 4N, R. 25E, W.M.

HISTORY OF ORIGINAL CORNER ESTABLISHMENT:

2 1/2" MARKED "1/16 PLS 933" BRASS CAP WAS SET BY KRUMBEIN IN 1978 PER MORROW COUNTY SURVEY NO. C-77-K-319.

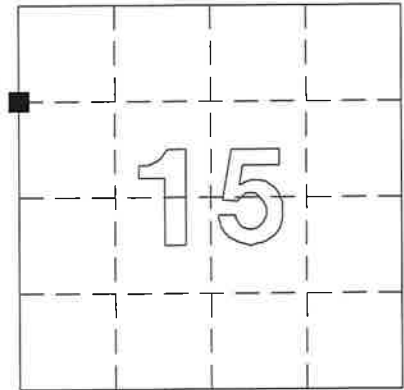


DESCRIPTION OF MONUMENT FOUND:

A 2 1/2" BRASS CAP MARKED " 1/16 PLS 933" PER MORROW COUNTY SURVEY NO. C-77-K-319 WAS FOUND PRIOR TO ROAD CONSTRUCTION. A 2" ALUMINUM CAP MARKED AS SHOWN BELOW ON 5/8" X 30" IRON ROD WAS SET AFTER CONSTRUCTION IN SAME LOCATION.

DESCRIPTION OF ACCESSORIES ESTABLISHED:

NEW ACCESSORIES:

- A 5/8"X30" IRON ROD WITH ALUMINUM CAP, MARKED "APA RM 49593PLS", BEARS N58°44'30"E, 33.76'
- A 5/8" IRON ROD WITH YELLOW PLASTIC CAP, MARKED "GBW WA 30440 OR 2817 PLS", BEARS N89°35'30"E, 30.02'

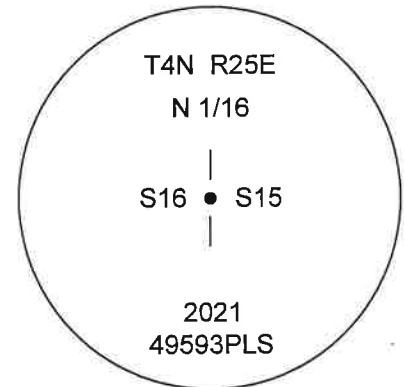

SPCS OREGON NORTH (International Feet)

Northing: 790391.36
Easting: 8409792.81

WITNESSES:

- RYAN HAYS, SURVEY PARTY CHIEF
- SAM SILVEIRA, SURVEY TECHNICIAN

**REGISTERED
PROFESSIONAL
LAND SURVEYOR**

OREGON
FEBRUARY 8, 2000
RICHARD E. STEIN
49593PLS

RENEWAL DATE: 06/30/2022



ANDERSON PERRY & ASSOCIATES, INC.
1901 N. FIR STREET
LA GRANDE, OR 97850
(541) 963-8309

8-9-2021

BY: MPK

NO. 4N 25 K13