

CERTIFIED RECORD OF LAND CORNER MONUMENTATION

COUNTY: MORROW

DATE: JUNE 11, 2021

CORNER DESIGNATION: L-13, 1/4 CORNER COMMON TO SECTIONS 15/16, T 4N, R 25E, W.M.

HISTORY OF ORIGINAL CORNER ESTABLISHMENT:

ORIGINAL CORNER WAS A POST SET ON ORIGINAL PLAT AND FIELD NOTES APPROVED BY E. L. APPLGATE, SURVEYOR GENERAL OF OREGON JANUARY 8, 1870

ON MORROW COUNTY SURVEY NO. C-77-K-319 (1978) KRUMBEIN FINDS A BRASS SCREW

ON PARTITION PLAT 1992-7 McKINNIS DID NOT FIND A MONUMENT AND SET A 3" BRASS CAP.


ON PARTITION PLAT 2003-6 PRIMM FINDS McKINNIS' BRASS CAP

ON MORROW COUNTY SURVEY NO. 1483-C FILED NOV. 14, 2006 COPPOCK FINDS A BRASS CAP.

ON PARTITION PLAT 2011-18 WAGNER FINDS 2 1/2" ALUM. CAP "LS #951 2002)

ON MORROW COUNTY SURVEY 2016-1777C HADDOCK FINDS 2" ALUM. CAP PER COUNTY SURVEY NO. 1631.

L-13
T. 4N, R. 25E, W.M.

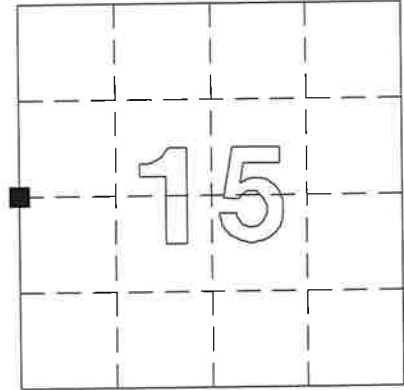


DESCRIPTION OF MONUMENT FOUND:

A 2" ALUMINUM CAP (MARKINGS ILLEGIBLE) WAS FOUND PRIOR TO ROAD CONSTRUCTION. A 2 1/2" COPPER CAP MARKED AS SHOWN BELOW ON 5/8" X 30" COPPER CLAD ROD WAS SET AFTER CONSTRUCTION IN SAME LOCATION.

DESCRIPTION OF ACCESSORIES ESTABLISHED:

NEW ACCESSORIES:

- SET A PUNCH MARK IN SOUTH RIM OF FIBER OPTIC MANHOLE, BEARS S65°03'24"W, 47.42'
- A 5/8"X30" IRON ROD WITH ALUMINUM CAP, MARKED "APA RM 49593PLS", BEARS N22°58'03"E, 68.87'
- A 5/8"X30" IRON ROD WITH ALUMINUM CAP, MARKED "APA RM 49593PLS", BEARS S65°38'34"E, 67.18'
- A 5/8" IRON ROD WITH YELLOW PLASTIC CAP, MARKED "EDWARDS 951", BEARS N34°27'05"W, 36.19'

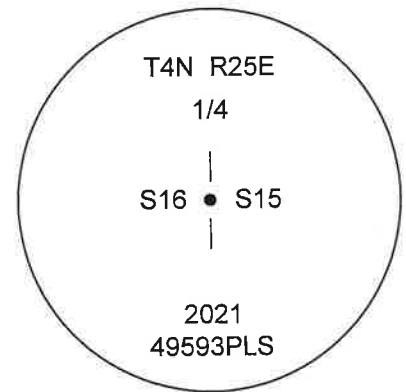

SPCS OREGON NORTH (International Feet)

Northing: 789037.87
Easting: 8409812.72

WITNESSES:

- RYAN HAYS, SURVEY PARTY CHIEF
- SAM SILVEIRA, SURVEY TECHNICIAN

**REGISTERED
PROFESSIONAL
LAND SURVEYOR**

OREGON
FEBRUARY 8, 2000
RICHARD E. STEIN
49593PLS

RENEWAL DATE: 06/30/2022

ANDERSON PERRY & ASSOCIATES, INC.
1901 N. FIR STREET
LA GRANDE, OR 97850
(541) 963-8309

8-9-2021

BY: MPK

NO: 4025L13