

CERTIFIED RECORD OF LAND CORNER MONUMENTATION


T.4N., R.25E., INDEX N-3

History of original corner establishment:

This corner was originally established by John B. David under G.L.O. contract No. 131, dated June 8, 1869. Survey General notes state:

Set post in mound as per instruction for 1/4 sec cor.

Corner re-established by Frank Tuers, BLM, in 1975. See Morrow County Map of Survey C-182-K.

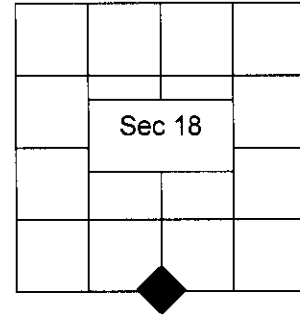

Description of corner evidence found:

We recover the railroad spike set by Tuers in 1975.

Description of monument and accessories I establish to perpetuate the original location of this corner:

At the position of the said railroad spike, set a 2-1/2" dia. x 30" steel pipe monument w/3" dia. brass cap stamped as shown in the DIAGRAM, 5" below the road grade, in a cast iron monument box, from which:

- A 5/8" iron pin bears N00°28'22"E, 20.00 ft., R/W pin Sta. 169+37.96, 20' Lt.
- A 5/8" iron pin bears S00°28'22"W, 30.00 ft., R/W pin Sta. 169+37.96, 30' Rt.

DIAGRAM

T4N R24E
S18
1/4----
S19
2009
PLS 49865

Measurements to accessories taken with Topcon Hyper Lite GPS.

I hereby certify that the above corner point was perpetuated as shown hereon in March, 2009

Witness: D. Mitchell Ferguson, LSIT
David H. Herburger, Surv. Tech.

Office of County Surveyor _____ County of Morrow
State of Oregon. I hereby certify that the within instrument was filed in this office
for record on the 16th day of April, 2014

Stephen K. Hallock by _____
County Surveyor Deputy

See Morrow County Map of Survey No. 2013-38D(1685)

REGISTERED
PROFESSIONAL
LAND SURVEYOR

OREGON
JULY 13, 1999
KENNETH H. DELANO JR.
49865
RENEWS: 1/1/2016