


**CERTIFIED RECORD OF LAND CORNER MONUMENTATION**

T.4N., R.25E., INDEX N-9

**History of original corner establishment:**

This corner was originally established by John B. David under G.L.O. contract No. 131, dated June 8, 1869. Survey General notes state:

Set post in mound as per instructions for corner to Secs 16, 17, 20, 21.

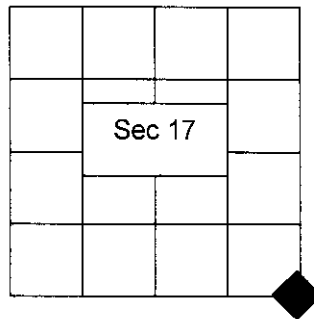

**Description of corner evidence found:**

Found a 5/8" iron pin at the record position of the corner. Accepted as the best available evidence of the corner location.

**Description of monument and accessories I establish to perpetuate the original location of this corner:**

At the position of the said 5/8" pin, set a 2-1/2" dia. x 30" steel pipe monument w/3" dia. brass cap stamped as shown in the DIAGRAM, 5" below the road grade, in a cast iron monument box, from which:

- A 5/8" iron pin bears N00°48'44"W, 30.00 ft., R/W pin Sta. 248+84.38, 20' Lt.
- A 5/8" iron pin bears S00°48'44"E, 20.00 ft., R/W pin Sta. 248+84.38, 20' Rt.
- A Brass Cap bears S44°30'29"W, 28.29 ft.

**DIAGRAM**

T4N R24E  
S17|S16  
----  
S20|S21  
2009  
PLS 49865

Measurements to accessories taken with Topcon Hyper Lite GPS.

I hereby certify that the above corner point was perpetuated as shown hereon in March, 2009

Witness: D. Mitchell Ferguson, LSIT  
David H. Herburger, Surv. Tech.

Office of County Surveyor \_\_\_\_\_ County of Morrow  
State of Oregon. I hereby certify that the within instrument was filed in this office  
for record on the 16<sup>th</sup> day of April, 2014

Stephen K. Harbord by \_\_\_\_\_  
County Surveyor Deputy

See Morrow County Map of Survey No. 2013-38D(1685)

REGISTERED  
PROFESSIONAL  
LAND SURVEYOR

*[Signature]*  
OREGON  
JULY 13, 1999  
KENNETH H. DELANO JR.  
49865

RENEWS: 1/1/2016