

OREGON CORNER RESTORATION FORM

A-3

Section 6 Township 4 N Range 26 E

County Morrow Date 6/30/86

CORNER DESIGNATION

N 1/4 Sec 6

Condition Report Only

Not Found

Renewed

Unrecorded

Surveyed In

Referenced Out

Previous Renewals/Surveys, etc. _____

GIO surveys in 1870, BIM resurvey in 1937


Monument(s) & Accessories Found: (Condition and Source)

None

Sketch

See Morrow County Surveyor

Drawing No. C-827-K

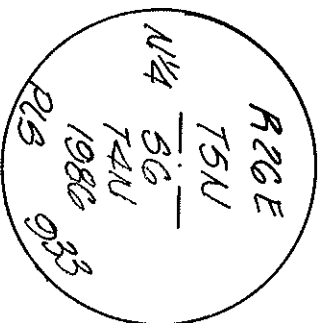

Monument Set (Procedures and Description)

Set 2 3/8" Brass Cap on 1 1/2" x 30" Galvanized iron pipe above ground

6" Steel fence post North 2.8 feet, Power Pole UECA 4N26E 064900

East 55.5 feet

New Accessories

None

Location & Comments

North of BPA right-of-way

1/2 mile East of Fish and Wildlife fence corner

Compass Declination _____

Firm/Agency Krumbein

Engineering Ltd

Address P.O. Box 1126

Pendleton, Oregon 97801

Party Chief J. Coppock

Notes _____

Witness _____

Surveyor's Seal

RECEIVED BY

Morrow County Surveyor

Date 7/28/86

Rec'd By MLD

No. 830-K