

OREGON CORNER RESTORATION FORM

A-5

Section 6 Township 4 N Range 26 E

County Morrow Date 6/30/86

CORNER DESIGNATION

NE corner Sec 6

- Condition Report Only
- Not Found
 - Renewed
 - Unrecorded
 - Surveyed In
 - Referenced Out

Previous Renewals/Surveys, etc.

GLO survey 1870, BIM resurvey 1937, unrecorded Rogers Surveying Inc.


drawing which identified some type of monument found

Monument(s) & Accessories Found: (Condition and Source)

None

Monument Detail

Sketch

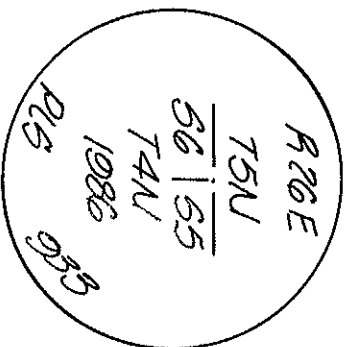

See Morrow County Surveyor
Drawing No. C-827-K

Monument Set (Procedures and Description)

Set 2 3/8" Brass Cap on 1 1/2" x 30" iron pipe above ground 6",

Steel fence post 1 foot North power pole UFGA 4N26E 06900 S 30°04'58" E

6.59 feet

New Accessories

None

Location & Comments

North of BPA right-of-way

1 mile East of Fish and

Wildlife fence

Compass Declination

Firm/Agency Krumbein

Engineering Ltd

Address P.O. Box 1126

Pendleton, Oregon 97801

Party Chief J. Coppock

Notes

Witness

Surveyor's Seal

RECEIVED BY

Morrow County Surveyor

Date 7/28/86

Rec'd By MID

No. 831-K