

**OREGON CORNER RESTORATION FORM**

SECTION: 2 TOWNSHIP: 4N RANGE: 26E C-21

COUNTY: MORROW DATE: 11/08

**CORNER DESIGNATION**

**CONDITION REPORT ONLY**  
 NOT FOUND  
 RENEWED  
 UNRECORDED  
 SURVEYED IN  
 REFERENCED OUT

*E 1/4 SEC. 2*



**PREVIOUS RENEWALS/SURVEYS ETC.**

Originally surveyed by Thompson under Contract #131 in 1869. Gould did a dependent resurvey in 1939. He set Brass Caps at all G.L.O. corners.

**MONUMENTS AND ACCESSORIES FOUND: CONDON AND SOURCE**

Nothing found, in a cultivated field.

**MONUMENT DETAIL**

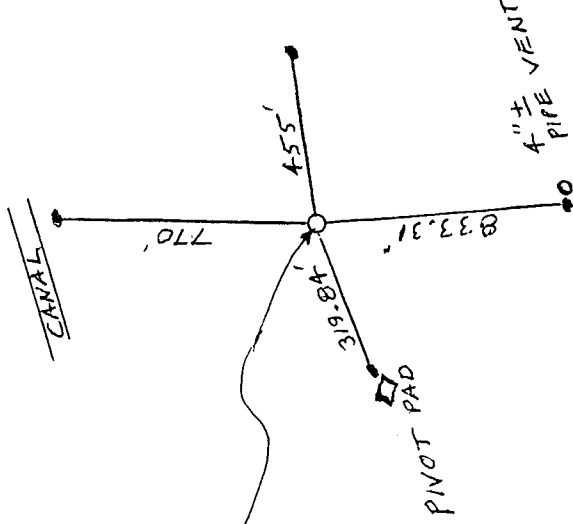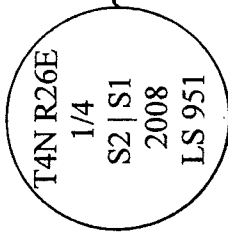

**MONUMENT SET PROCEDURES AND DESCRIPTION**

By retracing Gould's 1939 Survey (See My Partition Plat 2008-11) I set a 2 3/8" Brass Cap stamped as above on a 1" x 15" iron pipe 24" below the surface of a cultivated field. *ATTACHED PINK MAGNET TO IRON PIPE.*

**NEW ACCESSORIES FROM WHICH**

- A 5/8" x 30" Iron Rebar with plastic cap #951 bears N 0° 04' 44" W 770.00'
- A 5/8" x 30" Iron Rebar with plastic cap #951 bears N 80° 20' 31" E 454.99'
- A 5/8" x 30" Iron Rebar with plastic cap # 951 bears S 5° 35' 06" E 833.31'
- A 5/8" x 30" Iron Rebar with plastic cap # 951 bears S 66° 56' 42" W 319.84'

**LOCATION AND COMMENTS**

From intersection of Paterson Ferry Road and Depot Lane go East 1 Mile to road corner. Go South 500' across Canal Bridge. Go East 1 Mile along canal to Witness Corner. Go South 770' to corner.

SURVEYOR'S SEAL

FIRM: EDWARDS SURVEYING LLC  
PO BOX 763 - HERMISTON OR 97838

PARTY CHIEF: R. SMITH  
WITNESS: G. DENNIS EDWARDS

REGISTERED  
PROFESSIONAL  
LAND SURVEYOR

*G. Dennis Edwards*

OREGON  
JULY 16, 1971  
G. DENNIS EDWARDS  
951

RENEWS 12/31/

**RECEIVED BY**  
Morrow County Surveyors  
Date MAY 7 2009  
Rec'd By SKB  
No. C-21