

OREGON CORNER RESTORATION FORM

C-5

Section 6 Township 4N Range 26E

County Morrow Date 6/30/86

CORNER DESIGNATION

Condition Report Only

- Not Found
- Renewed
- Unrecorded
- Surveyed In
- Referenced Out

E 1/4 Sec 6

Previous Renewals/Surveys, etc. \_\_\_\_\_


GLO survey in 1870, BIM resurvey 1937

Monument(s) & Accessories Found: (Condition and Source)

None

Monument Detail

Sketch

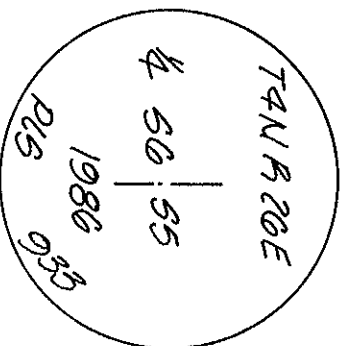

See Morrow County Surveyor  
Drawing No. C-827-K

Monument Set (Procedures and Description)

Set 2 3/8" Brass Cap on 1 1/2" x 30" iron pipe below ground 30" with magnet in pipe and 30" x 5/8" rebar with aluminum cap over Brass Cap.  
 Steel fence post 1 foot North power pole UECA 4N26E 069400 Southeast  
 7.60 feet

New Accessories

None

Location & Comments

North of BPA right-of-way

Compass Declination \_\_\_\_\_

Surveyor's Seal

Firm/Agency Krumbein

Engineering Ltd

Address P.O. Box 1126

Pendleton, Oregon 97801

Party Chief J Coppock

Notes \_\_\_\_\_

Witness \_\_\_\_\_

RECEIVED BY

Morrow County Surveyor

Date 7/28/86

Rec'd By MVD

No. 830-K