

OREGON CORNER RESTORATION FORM

E-1

Section Township 4 N Range 25 & 26 E

County Morrow Date 6/30/86

CORNER DESIGNATION

T 4 N

R 25 E R 26 E

1 | 6
12 | 7

Previous Renewals/Surveys, etc.

Condition Report Only
 Not Found
 Renewed
 Unrecorded
 Surveyed In
 Referenced Out


G10 survey 1870, BLM resurvey 1937, unrecorded Rogers Surveying, Inc.
drawing showing distances to adjacent corners.

Monument(s) & Accessories Found: (Condition and Source)

None

Monument Detail

Sketch

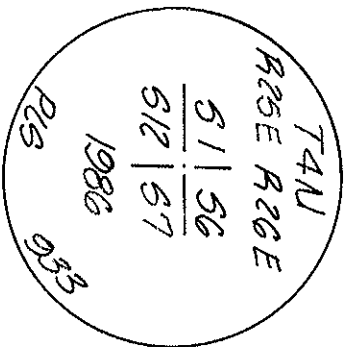

See Morrow County Surveyor
Drawing No. C-827-K

Monument Set (Procedures and Description)

Set 2 3/8" Brass Cap on 1 1/2" x 30" iron pipe below ground 30" with
magnet in pipe nad 30" x 5/8" rebar with aluminum cap over Brass Cap
Steel fence post 1 foot North

New Accessories

None

Location & Comments

North of BPA right-of-way under crop circle
Compass Declination
Firm/Agency Krumbein
Engineering Ltd

Surveyor's Seal

RECEIVED BY

Morrow County Surveyor

Date 7/28/86

Rec'd By MILD

No. 834-K

Address P.O. Box 1126

Pendleton, Oregon 97801

Party Chief J Coppock

Notes

Witness