

OREGON CORNER RESTORATION FORM

SECTION: 3 TOWNSHIP: 4N RANGE: 26E E-13

COUNTY: MORROW DATE: 9/2013

CORNER DESIGNATION

SW 3

CONDITION REPORT ONLY
 NOT FOUND
 RENEWED
 UNRECORDED
 SURVEYED IN
 REFERENCED OUT

PREVIOUS RENEWALS/SURVEYS ETC.


Originally surveyed by Thompson, et al, under Contract #131 in 1869. Gould did a dependent resurvey in 1939 and set an iron pipe with a 3 1/2" brass cap. In 1998 C.S. #972 Wagner found Gould's "3 1/2" brass cap".

MONUMENTS AND ACCESSORIES FOUND: CONDITON AND SOURCE

Nothing found.

MONUMENT DETAIL

T4N R26E
S4 | S3
S9 | S10
2013
LS 951

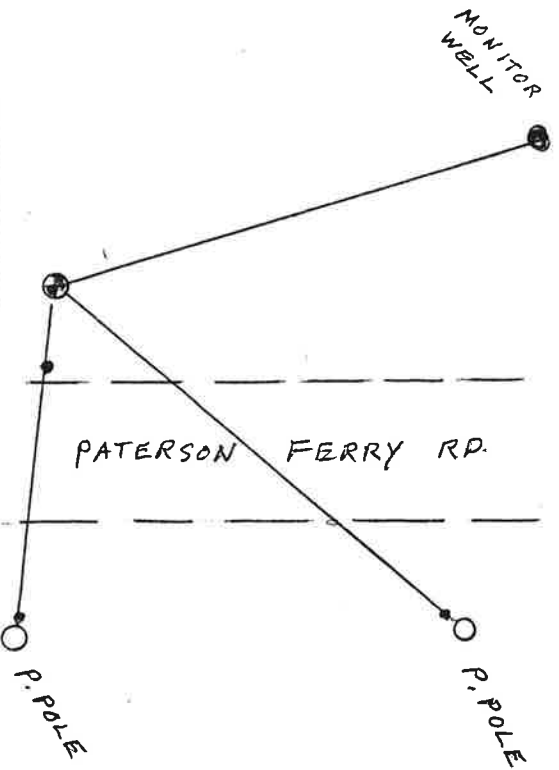

MONUMENT SET (PROCEDURES AND DESCRIPTION)

By retracing Wagner's C.S. #972 I set a 1" by 15" iron pipe with a 2 1/2" brass cap stamped as above, in concrete 24" below the surface of a cultivated field. See my survey this month for Cleaver Farming.


NEW ACCESSORIES FROM WHICH

- A 5/8" x 30" Iron Rebar with plastic cap #951 bears S 79° 02' 47" E 20.00'
- A 5/8" x 30" Iron Rebar with plastic cap #951 bears S 79° 02' 47" E 77.11'
- A 5/8" x 30" Iron Rebar with plastic cap #951 bears N 17° 29' 46" E 244.74'
- A 6" metal monitoring well bears N 8° 10' 05" W 426.25'

LOCATION AND COMMENTS

From the intersection of Depot Lane and Paterson Ferry Road go South 1/2 mile on Paterson Ferry. Corner lies 40' ± West of c/l of road.

SURVEYOR'S SEAL

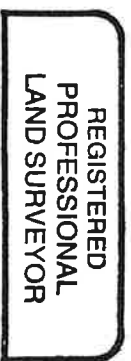

G. Dennis Edwards



RECEIVED BY

Morrow County Surveyor

Date: 9-30-2013
Rec'd By: S.K.H.
No.: 41126 E13
Folder No.: 1682

FIRM: EDWARDS SURVEYING LLC
PO BOX 763 - HERMISTON OR 97838

PARTY CHIEF: G. EDWARDS
WITNESS: R. FRITZ

RENEWWS 12/31/13