

Record of Land Corner Monumentation

Sections 6 & 7 Township 4N Range 26E Code T4N R26E E03

County Morrow Date September 17, 2015

History of Original Corner Establishment:

The corner was first established in 1869 by J. B. David in Original GLO Survey of Township 4 North, Range, 26 East under Contract No. 131.
Record Reads: Set Post in Mound for 1/4 Corner.
O. O. Gould completed a Dependent Resurvey in 1939.
Record Reads: Set Brass Cap on 1" x 36" Iron Post.
In 1986 Krumbein set a 2 3/8" Brass Cap on 1 1/2" x 30" Iron Pipe below ground under Morrow County Survey C-827-K.

Description of evidence found:

Found 2 3/8" Brass Cap on 1 1/2" x 30" Iron Pipe buried in ground & Set by Krumbein under Morrow County Survey C-827-K. The Brass Cap fell in the center of alignment for a Proposed Roadway and would be Destroyed by Construction.

Description of monumentation and accessories established to perpetuate the location of this Section Corner:



I Referenced and Removed the Monument Set by Krumbein Prior to Construction. After Construction I Reset the Monument at the Referenced Corner Location inside an Aluminum Monument Box in a Paved Bike/Ped. Trail South of the Center of Completed Road, Lewis & Clark Drive.

In addition, the following Bearing Objects were Tagged with Bearing Object Placards and a Washer Stamped PLS 2431 as follows, or as described:
All Bearings & Distances are to the Center of the Washer or Plastic/Alum. Cap as Described.

- 1 - A 5/8" Rebar w/Alum. Cap in C.L. Asphalt, Port of Morrow Control, #2431 bears N 01° 18' 16" W 22.58 ft. (Placard not Posted)
- 2 - A Steel Pole for Street Light bears N 21° 17' 00" E 84.48 feet.
- 3 - A Wood Power Pole bears S 50° 42' 45" E 59.37 feet.
- 4 - A Wood Power Pole bears S 43° 34' 12" W 53.73 feet.
- 5 - A 5/8" Rebar w/Plastic Cap #2431 bears N 36° 30' 40" W 86.73 feet.

All directions on placards are given to the set monument.

Re-Set Krumbein
Cap as Shown

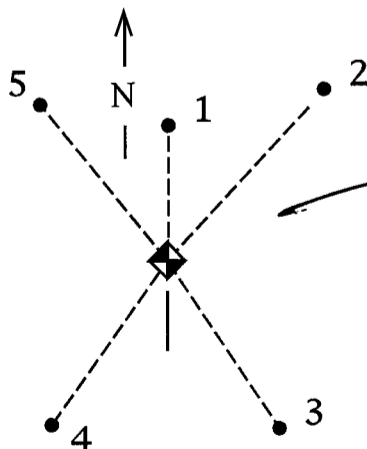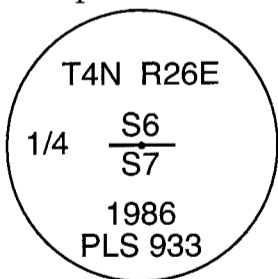

Office of County of Morrow
State of Oregon I hereby certify that the within instrument was
filed in this office for record on the 22 day of October, 2015
County Surveyor by Steph K. Haddock Survey Number 4N26E3
(COUNTY OFFICIAL) (DEPUTY)