

Record of Land Corner Monumentation

Sections 5,6,7,& 8 Township 4N Range 26E Code T4N R26E E05

County Morrow Date September 17, 2015

History of Original Corner Establishment:

The corner was first established in 1869 by J. B. David in Original GLO Survey of Township 4 North, Range, 26 East under Contract No. 131.

Record Reads: Set Post in Mound for Corner of Sections 5, 6, 7, & 8.

O. O. Gould completed a Dependent Resurvey in 1939.

Record Reads: Set Brass Cap on 2" x 36" Iron Post.

Description of evidence found:

Found 2 1/2" Brass Cap on 2" x 36" Iron Pipe buried 4 feet in ground & Set by O. O. Gould under GLO Dependent Survey in 1939. The Brass Cap fell in the center of alignment for a Proposed Roadway and would be Destroyed by Construction.

Description of monumentation and accessories established to perpetuate the location of this Section Corner:

I Referenced and Removed the GLO Monument Set by O. O. Gould Prior to Construction. After Construction I Reset the Monument at the Referenced Corner Location inside an Aluminum Monument Box in the Center Line of the Completed Road, Lewis & Clark Drive.



In addition, the following Bearing Objects were Tagged with Bearing Object Placards and a Washer Stamped PLS 2431 as follows, or as described:

All Bearings & Distances are to the Center of the Washer or Plastic/Alum. Cap as Described.

- 1 - A 5/8" Rebar w/ Plastic Cap #951 bears N 0° 04' 12" E 306.58 feet.
Edwards (#951) Placard left in place.
- 2 - A Steel Pole for Street Light bears N 67° 55' 47" E 76.65 feet.
- 3 - A 5/8" Rebar w/Alum. Cap in C.L. Asphalt, Port of Morrow Control #2431 bears N 89° 08' 32" E 45.91 ft. (Placard not Posted)
- 4 - A Wood Power Pole bears S 06° 29' 55" E 45.00 feet.
- 5 - A Steel Pole for Street Light bears S 78° 00' 55" W 163.03 feet.
- 6 - A 5/8" Rebar w/Plastic Cap #951 bears N 41° 56' 52" W 419.06 feet.
Edwards (#951) Placard left in place.

All directions on placards are given to the set monument.

Re-Set GLO Cap
Correctly Oriented
as Shown

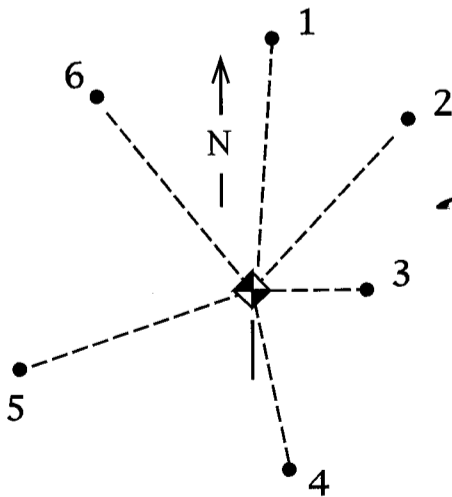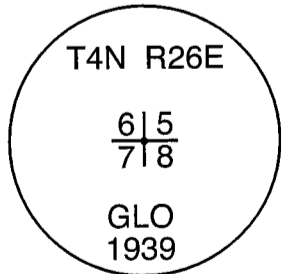

Expires 12-31-16

Office of County of Morrow
 State of Oregon I hereby certify that the within instrument was
 filed in this office for record on the 22 day of October, 2015
 County Surveyor by Steph K. Harbuck
(COUNTY OFFICIALS) (DEPUTY)

Survey Number 4N 26E 5