

OREGON CORNER RESTORATION FORM

SECTION: 5 TOWNSHIP: 4N RANGE: 26E E-5

COUNTY: MORROW DATE: 9/2013

CORNER DESIGNATION

SW SEC. 5

 CONDITION REPORT ONLY

 NOT FOUND

RENEWED

 UNRECORDED

 SURVEYED IN

REFERENCED OUT

PREVIOUS RENEWALS/SURVEYS ETC.


Originally surveyed by Thompson, et al, under Contract #131 in 1869.
Gould did a dependent resurvey in 1939 and set an iron pipe with a 3" brass cap.

MONUMENTS AND ACCESSORIES FOUND: CONDITION AND SOURCE

Found 3" brass cap 30" below the surface stamped as below with 1939 date & G.L.O. The letters and numbers are oriented South, not North.

MONUMENT DETAIL

T4N R26
S6 | S5
S7 | S8
2013
LS 951

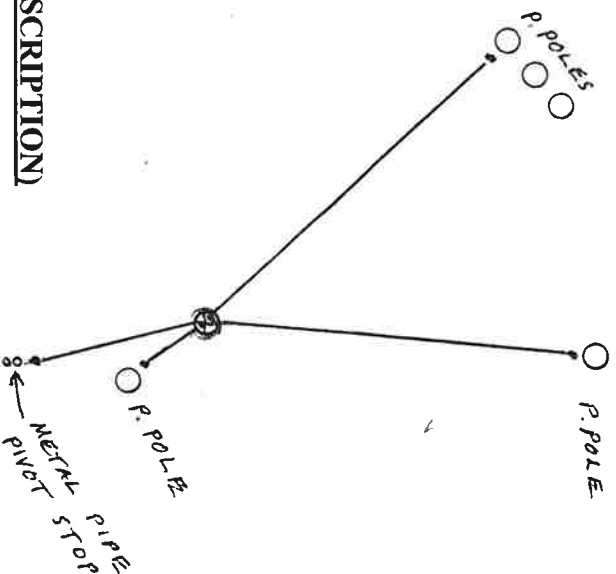

MONUMENT SET PROCEDURES AND DESCRIPTION

I set a 30" iron pipe with a 2 1/2" brass cap, stamped as above, on top of the 1939 brass cap with the top flush with the surface and poured a collar of concrete around it about a foot below the surface. It was in loose sand.

NEW ACCESSORIES FROM WHICH

- A 5/8" x 30" Iron Rebar with plastic cap #951 bears N 0° 43' 55" E 306.57'
- A 5/8" x 30" Iron Rebar with plastic cap #951 bears N 41° 17' 09" W 419.06'
- A 5/8" x 30" Iron Rebar with plastic cap #951 bears S 11° 09' 57" E 23.77'
- A 5/8" x 30" Iron Rebar with plastic cap #951 bears S 2° 19' 46" E 170.90'

LOCATION AND COMMENTS

From the east end of a RR overpass on Hwy. #730 go NE on Hwy. 730 about one half mile to a Power line. Then go North along power line about 0.3 mile to corner.

SURVEYOR'S SEAL

REGISTERED
PROFESSIONAL
LAND SURVEYOR

G. Dennis Edwards

OREGON
JULY 16, 1971
G. DENNIS EDWARDS
951

RENEWS 12/31/13

RECEIVED BY

Morrow County Surveyor

Date: 9-30-2013

Rec'd By: S.K.H.

No.: 41126ES

Folder No.: 1682

FIRM: EDWARDS SURVEYING LLC
PO BOX 763 - HERMISTON OR 97838

PARTY CHIEF: G. EDWARDS

WITNESS: R. FRITZ