

OREGON CORNER RESTORATION FORM

SECTION: 9 TOWNSHIP: 4N RANGE: 26E G-13

COUNTY: MORROW DATE: 9/2013

 CONDITION REPORT ONLY

 NOT FOUND

 X RENEWED

 UNRECORDED

 SURVEYED IN

 X REFERENCED OUT

E 1/4 COR. 9

PREVIOUS RENEWALS/SURVEYS ETC.


Originally surveyed by Thompson, et al, under Contract #131 in 1869.
Gould did a dependent resurvey in 1939 and set an iron pipe with a 2 1/2" brass cap.

MONUMENTS AND ACCESSORIES FOUND: CONDITON AND SOURCE

Found 1" iron pipe with 2 1/2" brass cap, stamped as below with 1939 date, bent to the SW.

MONUMENT DETAIL

T4N R26
S9 | S10
2013
LS 951

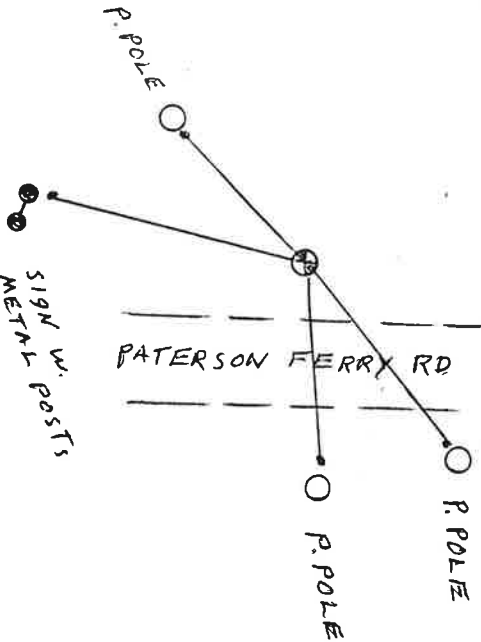

MONUMENT SET (PROCEDURES AND DESCRIPTION)

At the bend of the 1939 iron pipe I drove a 5/8" by 30" iron rebar with a 2" aluminum cap stamped as above flush with the ground.

NEW ACCESSORIES FROM WHICH

- A 5/8" x 30" Iron Rebar with plastic cap #951 bears N 33° 00' 40" E 102.40'
- A 5/8" x 30" Iron Rebar with plastic cap #951 bears N 86° 54' 11" E 77.05'
- A 5/8" x 30" Iron Rebar with plastic cap #951 bears S 5° 20' 09" W 135.42'
- A 5/8" x 30" Iron Rebar with plastic cap #951 bears S 27° 16' 22" W 75.82'

LOCATION AND COMMENTS

From the intersection of Depot Lane and Paterson Ferry Road go South 1 mile on Paterson Ferry. Corner lies 40'± West of c/l of road.

SURVEYOR'S SEAL

REGISTERED
PROFESSIONAL
LAND SURVEYOR

G. Dennis Edwards

OREGON
JULY 16, 1971
G. DENNIS EDWARDS
951

RENEWS 12/31/13

RECEIVED BY
Morrow County Surveyor

Date: 9-30-2013
Rec'd By: S.K.H
No.: 4N 26 G13
Folder No.: 1682

FIRM: EDWARDS SURVEYING LLC
PO BOX 763 - HERMISTON OR 97838

PARTY CHIEF: G. EDWARDS
WITNESS: R. SMITH