

CERTIFIED RECORD OF LAND CORNER MONUMENTATION / RESTORATION

T.4N., R.26E., INDEX N-23

History of original corner establishment:

This corner was originally established by John B. David under G.L.O. contract No. 131, dated June 8, 1869. Survey General notes state:


Set post in mound as per instructions for 1/4 Sec. corner.

In 1939, Otis Gould, under special instructions dated January 26, 1938, set a GLO brass cap monument at proportionate measure. The field notes state:

40.09 1/2 Proportionate measurement. Set an iron post, 3 ft. long, 1 in. diam., 27 ins. in the ground, for 1/4 sec. cor.

In 1987, The Army Corps. of Engineers performed a partial boundary survey of the Umatilla Depot, titled "Umatilla Depot Activity, Boundary Survey". The monumentation notes state:

*A-2= 11-1= 1/4 S.13 / S24
Replaced bent 1939 G.L.O. Cap and Pipe in position of undisturbed portion of pipe.*

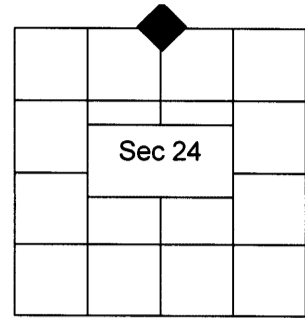

Description of corner evidence found:

No evidence of this corner is found. Set monument at the record position as returned on the 1987 Army Corps. of Engineer's Depot Survey.

Description of monument and accessories I establish to perpetuate the original location of this corner:

At the record position determined by survey, Set a 2-1/2" x 30" aluminum pipe monument with 3" dia. cap stamped as shown in the DIAGRAM, 28" in the ground, from which:

- A 5/8" rebar pin bears N39°25'00"W, 19.72 ft.
- A 5/8" rebar pin with 1 groove filed on the top, bears N51°34'23"E, 18.53 ft.
- A 5/8" rebar pin with 2 grooves filed on the top, bears S41°32'34"E, 18.42 ft.
- A 5/8" rebar pin with 3 grooves filed on the top, bears S51°38'43"W, 18.97 ft.

Placed an orange plastic cap marked "FS&E Survey Marker" on all rebar pins. Set a green steel "T" post with white top 1 ft. north of monument.

Measurements to accessories taken with: Topcon Hyper II GPS (RTK)

I hereby certify that the above corner point was perpetuated as shown hereon on July 30, 2015

Witness: D. Mitchell Ferguson, LSIT
David Herburger

Office of County Surveyor County of Morrow
State of Oregon. I hereby certify that the within instrument was filed in this office for record on the 13th day of January, 2016

Stephen K. Haddock by _____
County Surveyor Deputy

Refer to Map of Survey # 2016-1752D

DIAGRAM

T4N R26E
S13
1/4 ----
S24
2015
PLS 49865

