

# OREGON CORNER RESTORATION FORM

SECTION 25|30

TOWNSHIP 4 NORTH

RANGE 25|26 EAST

COUNTY: MORROW

DATE: 03/01/2016

CORNER DESIGNATION: T-1

## PREVIOUS RENEWALS / SURVEYS, etc.


THE ORIGINAL CORNER SET BY U.S. DEPUTY SURVEYOR J. DAVID IN 1869. HE SET A POST IN MOUND.

OTIS GOULD CONDUCTED A DEPENDENT RESURVEY COMPLETED IN 1939. AT THAT TIME HE FOUND A ROTTEN STAKE WITH TRACES OF SCRIBE MARKS, AND SET A 2" DIAMETER 3' LONG IRON POST WITH A BRASS CAP AND DEPOSITED THE ORIGINAL STAKE BENEATH, AND DUG PITS.

## MONUMENT and ACCESSORIES FOUND: ( CONDITION AND SOURCE )

AT THE CORNER POSITION, WE FIND GOULD'S 1939 CORNER WHICH APPEARS UNDISTURBED, THE LOCATION OF WHICH SUBSTANTIALLY AGREES WITH BOTH THE GLO RECORD AND CUNNINGTON'S SURVEY FOR THE US NAVY (C-810-K). N63°24'20"W 8.73' FROM SAID GLO MONUMENT, WE FIND A 2.5" BRASS CAP, STAMPED AS BEING THE SAME CORNER, SET BY McKINNIS (LS 2431) ON HIS SURVEY FOR THE MORROW COUNTY COURT (D-1410-M). WE REJECT THE McKINNIS MONUMENT AND ACCEPT THE GLO MONUMENT AS THE TRUE CORNER.

## DIAGRAM:

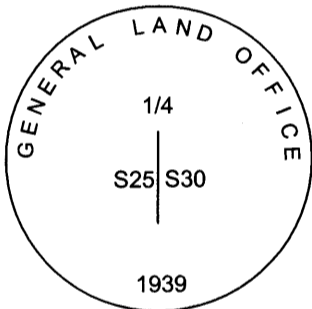

## MONUMENT and ACCESSORIES SET ( PROCEDURES and DESCRIPTION )

FOUND A 2-1/2" BRASS CAP ON A 1" I.D. 30" LONG FLARED PIPE. MARKED AS SHOWN.

## REFERENCES SET:

From the McKinnis brass cap the corner bears S 63°24'20" E 8.73'  
From a utility pole the corner bears S 42°03' E 4.2'  
From the East Leg of a BPA tower the corner bears S 53° 58' E 195.5'  
From a power pole the corner bears S 2°18' E 77.0'  
From a power pole the corner bears N 0°17' E 246.5'

(Bearings are Grid)  
LOCATION and COMMENTS

NAD83 / 2011 Oregon North coordinates (International Feet)  
N 778669.32  
E 8425775.70

## SURVEYORS SEAL

REGISTERED  
PROFESSIONAL LAND  
SURVEYOR

OREGON  
NOVEMBER 13, 2012  
DAVID P. BAALMAN  
86848PLS

RENEWS: 12/31/2017

5-12-16 *[Signature]*

## RECEIVED BY:

MORROW COUNTY SURVEYOR

DATE 5-17-2016

REC'D BY: S.K.H.

NO. 4N26 T1

## FIRM / AGENCY

ROGERS SURVEYING, Inc., P.S.  
1455 COLUMBIA PARK TRAIL, #201  
RICHLAND, WA 99352  
(509) 783-4141