

OREGON CORNER RESTORATION FORM

SECTION 35-36-1-2

TOWNSHIP 3 & 4 NORTH

RANGE 26 EAST

COUNTY: MORROW

DATE: 03/01/2016

CORNER DESIGNATION: Z-21

PREVIOUS RENEWALS / SURVEYS, etc.


THE ORIGINAL CORNER SET BY U.S. DEPUTY SURVEYOR E.E.HAFT IN 1861. HE DEPOSITED A PINT OF CHARCOAL, SET A POST AND RAISED A MOUND WITH TRENCHES AND PITS.

OTIS GOULD CONDUCTED A DEPENDENT RESURVEY COMPLETED IN 1941. AT THAT TIME HE SET A 2" DIAMETER 3' LONG IRON POST WITH A BRASS CAP AND DUG PITS. IN THE EARLY 1970'S ROGERS SURVEYING INC. SURVEYED THIS CORNER AS PART OF WORK FOR DEVELOPMENT OF SABRE FARMS (SEE SURVEY 2016-1759C).

MONUMENT and ACCESSORIES FOUND: (CONDITION AND SOURCE)

NO EVIDENCE WAS FOUND OF THE MONUMENT.

DIAGRAM:

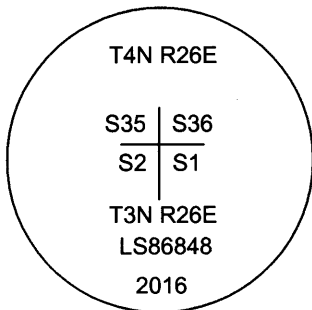

MONUMENT and ACCESSORIES SET (PROCEDURES and DESCRIPTION)

SET A 2-1/2" BRASS CAP ON A 1" I.D. 30" LONG FLARED PIPE. MARKED AS SHOWN, AT POSITION PER 1973 SURVEY BY ROGERS SURVEYING FOR SABRE FARMS (2016-1759C), AS DETERMINED BY GRANT BOUNDARY METHOD AGAINST CORNERS EAST & WEST

REFERENCES SET:

From a tee post on the north side of a farm road the corner bears S0°00'E 1.5'
From a power pole (UEC 029902) the corner bears N82°14'E 187.3'
From a power pole (UEC 029903) the corner bears N65°30'W 59.2'
From a tee post the corner bears N14°58'E 117.5'
(Bearings are Grid)

LOCATION and COMMENTS

NAD83 / 2011 Oregon North coordinates (International Feet)
N 771008.21
E 8452506.47

SURVEYORS SEAL

REGISTERED
PROFESSIONAL LAND
SURVEYOR

OREGON
NOVEMBER 13, 2012
DAVID P. BAALMAN
86848PLS

RENEWS: 12/31/2017

5-17-16

RECEIVED BY:

MORROW COUNTY SURVEYOR

DATE 5-17-16

REC'D BY: S.K.H.

NO. 4N26Z21

FIRM / AGENCY

ROGERS SURVEYING, Inc., P.S.
1455 COLUMBIA PARK TRAIL, #201
RICHLAND, WA 99352
(509) 783-4141