


**CERTIFIED RECORD OF LAND CORNER MONUMENTATION / RESTORATION**

T.4N., R.27E., INDEX A-13

**History of original corner establishment:**

This corner was originally established by Nicholas Walden under G.L.O. contract No. 209, dated July 6, 1874. Survey General notes state:

*Drove charred stake and raised mound of earth with pits as Per instructions for Closing Cor to Secs 3 & 4. Drove Willow stake 2 ft long 2 in square in E pit.*

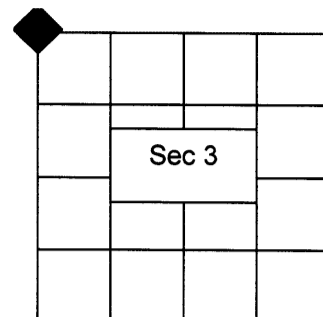

**Description of corner evidence found:**

No evidence of this corner is found. Set monument at single proportionate measure.

**Description of monument and accessories I establish to perpetuate the original location of this corner:**

At proportionate position determined by survey, Set a 2-1/2" x 30" aluminum pipe monument with 3" dia. cap stamped as shown in the DIAGRAM, 28" in the ground, from which:

- A 5/8" rebar pin bears N47°10'08"W, 21.45 ft.
- A 5/8" rebar pin with 1 groove filed on the top, bears N39°26'02"E, 20.67 ft.
- A 5/8" rebar pin with 2 grooves filed on the top, bears S48°13'57"E, 20.40 ft.
- A 5/8" rebar pin with 3 grooves filed on the top, bears S41°39'11"W, 21.99 ft.

Placed an orange plastic cap marked "FS&E Survey Marker" on all rebar pins. Set a green steel "T" post with white top 1 ft. north of monument.

**DIAGRAM**

T5N R27E  
S33  
-----  
S3 | S4  
T4N R27E  
2015  
PLS 49865

Measurements to accessories taken with: Topcon Hyper II GPS (RTK)

I hereby certify that the above corner point was perpetuated as shown hereon on July 30, 2015

Witness: D. Mitchell Ferguson, LSIT

David Herburger

Office of County Surveyor \_\_\_\_\_ County of Morrow  
State of Oregon. I hereby certify that the within instrument was filed in this office  
for record on the 13<sup>th</sup> day of January, 2016

Stephen K. Haddock by \_\_\_\_\_  
County Surveyor Deputy

Refer to Map of Survey # 2016-1752D

