


CERTIFIED RECORD OF LAND CORNER MONUMENTATION / RESTORATION

T.4N., R.27E., INDEX E-13

History of original corner establishment:

This corner was originally established by Nicholas Walden under G.L.O. contract No. 209, dated July 6, 1874. Survey General notes state:

Drove charred stake and raised mound of earth with pits as Per instructions for Cor to Secs 3, 4, 9 & 10. Drove Willow stake 2 ft long 2 in square in SE pit.

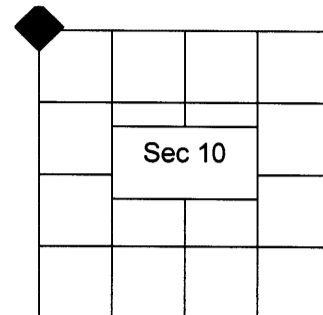

Description of corner evidence found:

No evidence of this corner is found. Set monument at double proportionate measure.

Description of monument and accessories I establish to perpetuate the original location of this corner:

At proportionate position determined by survey, Set a 2-1/2" x 30" aluminum pipe monument with 3" dia. cap stamped as shown in the DIAGRAM, 28" in the ground, from which:

- A 5/8" rebar pin bears N73°16'06"W, 27.26 ft.
- A 5/8" rebar pin with 1 groove filed on the top, bears N30°11'11"E, 25.50 ft.
- A 5/8" rebar pin with 2 grooves filed on the top, bears S66°17'39"E, 26.73 ft.
- A 5/8" rebar pin with 3 grooves filed on the top, bears S10°04'29"W, 28.10 ft.

Placed an orange plastic cap marked "FS&E Survey Marker" on all rebar pins. Set a green steel "T" post with white top 1 ft. north of monument.

DIAGRAM

T4N R27E
S4 | S3

S9 | S10
2015
PLS 49865

Measurements to accessories taken with: Topcon Hyper II GPS (RTK)

I hereby certify that the above corner point was perpetuated as shown hereon on July 29, 2015

Witness: D. Mitchell Ferguson, LSIT
David Herburger

Office of County Surveyor County of Morrow
State of Oregon. I hereby certify that the within instrument was filed in this office
for record on the 13th day of January, 2016

Stephen K. Haddock by _____
County Surveyor Deputy

Refer to Map of Survey # 2016-1752D

