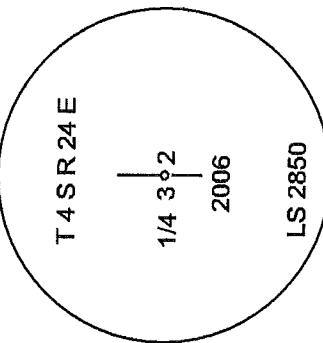
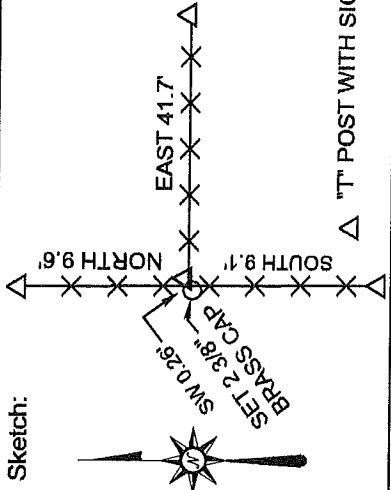



C-17

OREGON PUBLIC LAND CORNER REPORT / RESTORATION REPORT

MORROW COUNTY SURVEYOR'S OFFICE

SECTION 1/4 3/2	TOWNSHIP T 4 S	RANGE R 24 E
WILLAMETTE MERIDIAN, MORROW COUNTY, OREGON      DATE: 29 APRIL 06		
CORNER DESIGNATION: (Please check one)		
<input type="checkbox"/> Condition Report Only <input type="checkbox"/> Not Found <input type="checkbox"/> Renewed <input type="checkbox"/> Unrecorded <input checked="" type="checkbox"/> Surveyed In <input type="checkbox"/> Referenced Out		
ONE QUARTER CORNER COMMON TO SECTIONS 3 AND 2, T 4 S, R 24 E OF THE WILLAMETTE MERIDIAN, MORROW COUNTY, OREGON.  Previous Renewals / Surveys, etc.  GLO CONTRACT 184, 1873 BY MOODY. STONE 36" X 18" X 8" SET		
Monument(s) & Accessories Found: (Condition & Source)  FOUND A 1.8' X 1.8' STONE LYING FLAT UNDER AN OLD BROKEN ROCK CRIB AT THE INTERSECTION OF AN FENCE RUNNING EAST AND A NORTH SOUTH FENCE. I COULD FIND NO MARKINGS ON FOUND STONE BUT ACCEPTED IT WITH THE ROCK CRIB AS BEING THE BEST EVIDENCE OF THE ORIGINAL CORNER.		
Monument Detail:  	Sketch:  	
Monument Set (Procedures and Description):  SET A 2 3/8" BRASS CAP MOUNTED ON A 2" X 30" FLAILED GALV. STEEL PIPE. AT FENCE INTERSECTION.		
New Accessories: CORNER POSTER ON "T" POST NORTH 9.6' CORNER POSTER ON "T" POST EAST 41.7' CORNER POSTER ON "T" POST SOUTH 9.1' CORNER POSTER AND WARNING SIGN ON "T" POST SOUTHWEST 0.26'		
Location & Comments:  LOCATED ALONG A NORTH-SOUTH FENCE SEPARATING CROPLAND, NO ROAD ACCESS.		Compass Declination:  NA
Firm / Agency    COPPOCK SURVEYING PO Box 495 HEPPNER, OR 97836		
Party Chief        JUDSON L. COPPOCK LS 2850		
Notes		
Witness		

REGISTERED  
 PROFESSIONAL  
 LAND SURVEYOR  
  
  
 OREGON  
 JUDSON L. COPPOCK  
 JANUARY 20 1998  
 2850

RENEWAL DATE: DEC 31, 2007