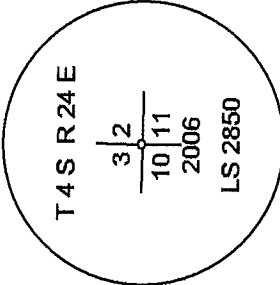
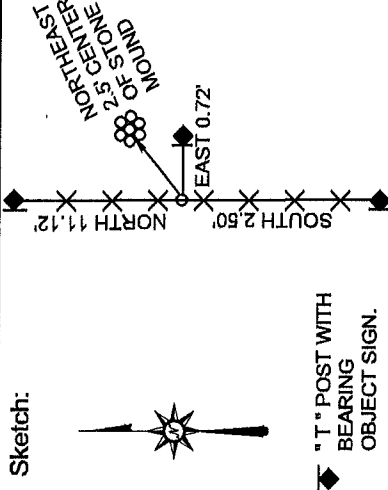
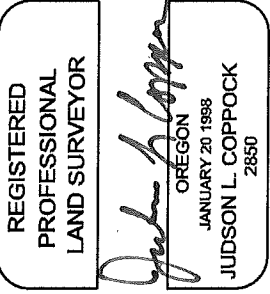


OREGON PUBLIC LAND CORNER REPORT / RESTORATION REPORT

MORROW COUNTY SURVEYOR'S OFFICE

MORROW COUNTY, OREGON		DATE: 1 MAY 2006			
CORNER DESIGNATION:					
(Please check one)					
<input type="checkbox"/> Condition Report Only					
<input type="checkbox"/> Not Found					
<input type="checkbox"/> Renewed					
<input type="checkbox"/> Unrecorded					
<input type="checkbox"/> Surveyed In					
<input checked="" type="checkbox"/> Referenced Out					
Previous Renewals / Surveys, etc.					
GLO CONTRACT 184, 1873 BY MOODY STONE 24 X 18 X 10 SET.					
Monument(s) & Accessories Found: (Condition & Source)					
FOUND A COLLAPSED ROCK CRIB AT CORNER.					
Monument Detail:			Sketch:		
					
2 3/8" BRASS CAP ON A 2" ID X 30" GALV. FLAIED PIPE					
Monument Set (Procedures and Description):					
SET A 2 3/8" BRASS CAP ON A 2" ID X 30" FLAIED GALV. PIPE.					
New Accessories: " T " POST WITH BEARING OBJECT SIGN NORTH 11.12'. " T " POST WITH BEARING OBJECT SIGN SOUTH 2.50'. " T " POST WITH WARNING AND BEARING OBJECT SIGN EAST 0.72'. MOUND OF STONE NORTHEAST 2.5'.					
Location & Comments:			Compass Declination:		
LOCATED IN NORTH-SOUTH FENCE, RANGE AND CROP LAND. NO ROAD ACCESS.			NOT DETERMINED		
Firm / Agency					
COPPOCK SURVEYING PO Box 495 HEPPNER, OR 97836					
Party Chief					
JUDSON L. COPPOCK LS 2850					
Notes					
SHANNON BENEFIT					
Witness					
SURVEYOR'S SEAL					
					
RENEWAL DATE: DEC. 31, 2007					