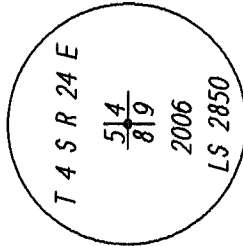
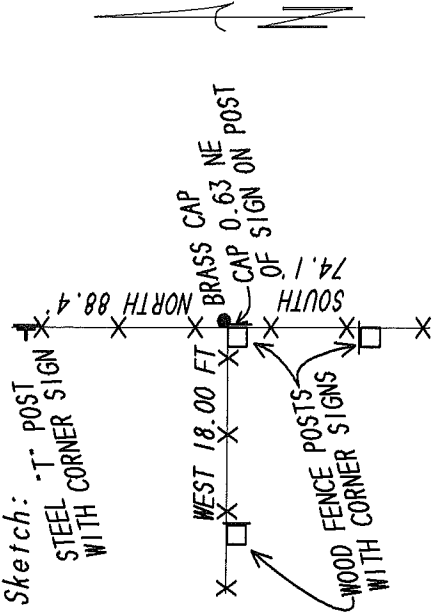


OREGON PUBLIC LAND CORNER REPORT / RESTORATION REPORT
MORROW COUNTY SURVEYOR'S OFFICE

E-9

SECTION <u>5</u> <u>4</u> <u>8</u> <u>9</u>	TOWNSHIP 4 SOUTH	RANGE 24 EAST. W.M.	DATE														
MORROW COUNTY																	
CORNER DESIGNATION: COMMON CORNER TO SECTIONS 4, 5, 8 AND 9, TOWNSHIP 4 SOUTH, RANGE 24 EAST OF THE WILLAMETTE MERIDIAN, MORROW COUNTY, OREGON																	
<table border="1" style="width: 100%; border-collapse: collapse;"> <tr> <td colspan="2" style="text-align: center;">(Please check one)</td> </tr> <tr> <td style="text-align: center;"><input type="checkbox"/></td> <td style="text-align: center;">Condition Report Only</td> </tr> <tr> <td style="text-align: center;"><input checked="" type="checkbox"/></td> <td style="text-align: center;">Not Found</td> </tr> <tr> <td style="text-align: center;"><input type="checkbox"/></td> <td style="text-align: center;">Renewed</td> </tr> <tr> <td style="text-align: center;"><input type="checkbox"/></td> <td style="text-align: center;">Unrecorded</td> </tr> <tr> <td style="text-align: center;"><input type="checkbox"/></td> <td style="text-align: center;">Surveyed In</td> </tr> <tr> <td style="text-align: center;"><input checked="" type="checkbox"/></td> <td style="text-align: center;">Referenced Out</td> </tr>
Previous Renewals / Surveys, etc. GLO CONTRACT 184. 1873 BY MOODY.																	
Monument(s) & Accessories Found: (Condition & Source) NO MONUMENTS FOUND. THERE IS A FENCE INTERSECTION AT THIS LOCATION. I ACCEPTED THIS FENCE INTERSECTION AS THE BEST EVIDENCE REMAINING OF THE GLO CORNER.																	
Monument Detail:		Sketch:															
Monument Set (Procedures and Description): 2 3/8" BRASS CAP ON A 2" ID X 30" FLAIRED GALV. PIPE.																	
New Accessories: PLACED 4 SIGNS ON POSTS AS SHOWN IN ABOVE SKETCH																	
Location & Comments: SURROUNDED BY CROPLAND AND NO ROAD ACCESS.		Compass Declination: NOT DETERMINED															
Firm / Agency COPPOCK SURVEYING PO Box 495 HEPPNER, OR 97836																	
Party Chief JUDSON L. COPPOCK LS 2850																	
Notes SHANNON BENEFIT																	
Witness																	

SURVEYOR'S SEAL

REGISTERED
PROFESSIONAL
LAND SURVEYOR

Judson L. Coppock
OREGON
JANUARY 20 1998
JUDSON L. COPPOCK
2850

RENEWAL DATE: DEC. 31, 2007