

OREGON CORNER RESTORATION FORM

Section 7 Township 4S Range 25E
County Morrow Date: April 24, 1999

Corner Designation: 4S25E3
quarter corner to sections 6 and 7, T4S, R25E, W.M.
Morrow County, Oregon

Condition Report Only
 Not found
 Remonumented
 Unrecorded
 Surveyed in
 Referenced out


Previous Renewals / Surveys, etc.

Corner originally set by Zenas F. Moody under contract No. 184 Dated March 29, 1873.
His record reads: Set stone 14x12x7 for 1/4 sec. cor.


Monument and Accessories found: (condition and source)

Found a mound of stone approximately 4' across on an open hillside with a record dimension stone in place on the west side of the mound. There were no other stones of record size and nothing else that appeared to be a mound within 200 feet of this mound. A few old fence posts could be found in the grass to the east of the mound approximately 100 feet away.

DIAGRAM

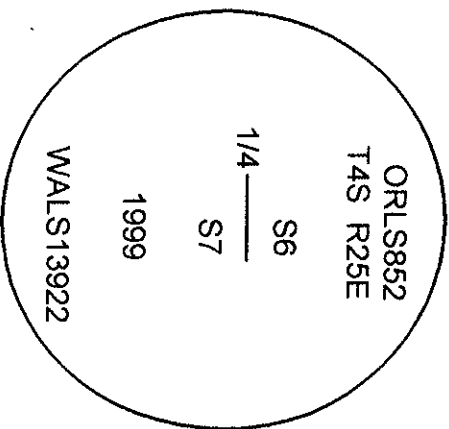

SKETCH

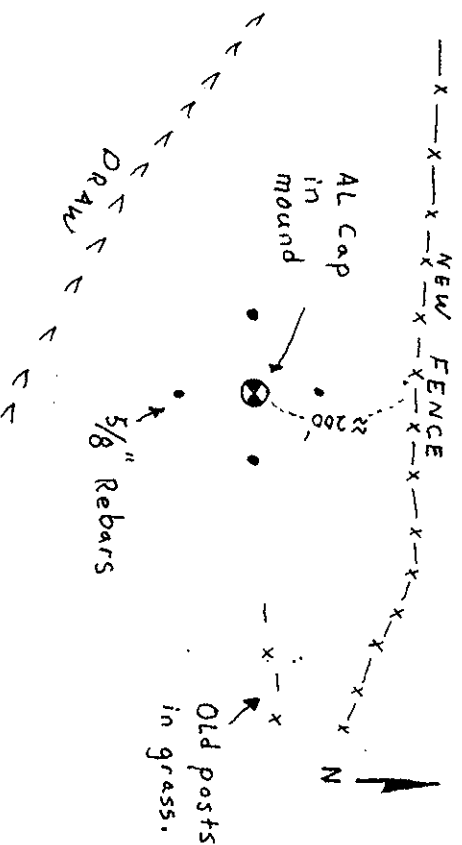

MONUMENT (S) AND ACCESSORIES SET (Procedures and Description)

Drove a 5/8"x24" rebar 22" into the ground with a 2" aluminum cap stamped as shown in the diagram above at the position of the stone and raised a mound of stone and around the cap. Buried the record stone along side the cap.

For references, I set four 5/8" by 24" rebars with 1.25" red plastic caps stamped ORLS 852 and WALS 13922 as described below:

- an iron rebar bears N04°39'W, 26.86 feet;
- an iron rebar bears N87°37'W, 39.87 feet;
- an iron rebar bears S04°51'W, 38.38 feet;
- an iron rebar bears S88°06'E, 40.98 feet;

The monument and references were tied using a LIECA system 300 RTK GPS.

Location and comments

Compass Declination

Surveyors Seal

RECEIVED BY:

Morrow County Surveyor

Date: _____

Rec'd By: _____

No. _____

Firm / Agency
Haddock Surveying
Address
P. O. Box 1574
Pendleton, Or. 97801
Party Chief
Stephen K. Haddock

REGISTERED
PROFESSIONAL
LAND SURVEYOR

David L. Haddock

OREGON
JULY 12, 1966
DAVID L. HADDOCK
852