

OREGON CORNER RESTORATION FORM

Section 7 Township 4S Range 25E
 County Morrow Date: April 24, 1999

Corner Designation: 4S25E5

Corner to sections 5, 6, 7, and 8, T4S, R25E, W.M.
 Morrow County, Oregon


Condition Report Only
 Not found
 Remonumented
 Unrecorded
 Surveyed in
 Referenced out

Previous Renewals / Surveys, etc.

Corner originally set by Zenas F. Moody under contract No. 184 Dated March 29, 1873.
 His record reads: Set stone 16x10x6 for cor. to secs. 7-8-5-6.

Monument and Accessories found: (condition and source)

Found a mound of stone approximately 3' across on an open hillside with a record dimension stone in place in the center of the mound. The stones do not look like stones that were just dumped as part of a field cleaning and were well settled into the soil.

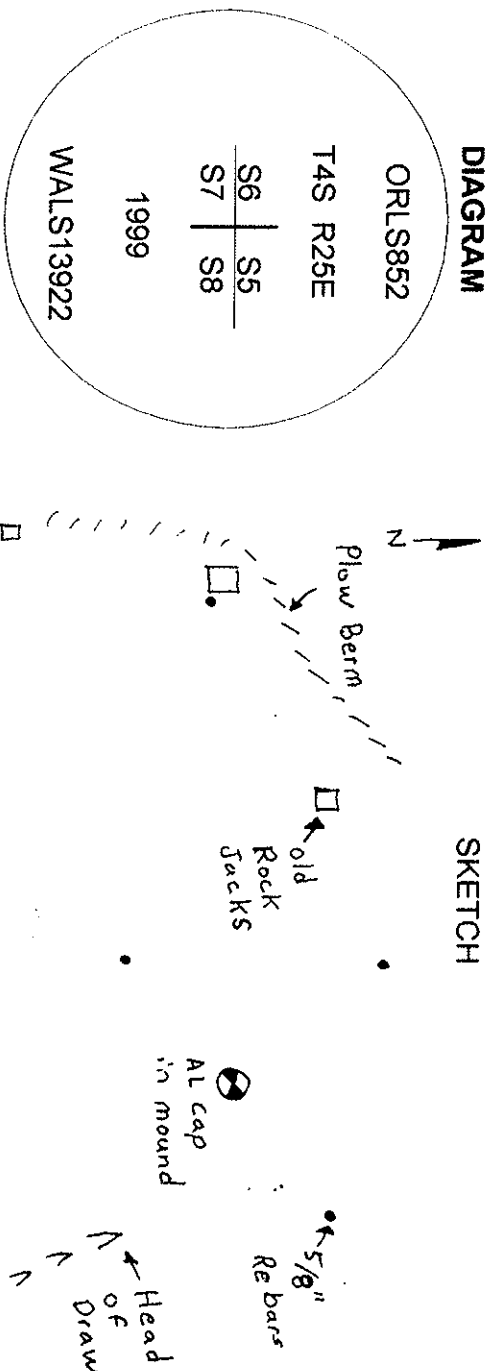

MONUMENT (S) AND ACCESSORIES SET (Procedures and Description)

Drove a 5/8"x24" rebar 22" into the ground with a 2" aluminum cap stamped as shown in the diagram above at the position of the stone and raised a mound of stone and around the cap. Buried the record stone along side the cap.

For references, I set four 5/8" by 24" rebars with 1.25" red plastic caps stamped ORLS 852 and WALS 13922 as described below:

- an iron rebar bears N16°03'W, 57.07 feet;
- an iron rebar bears N50°15'E, 39.84 feet;
- an iron rebar bears S63°25'W, 65.40 feet in a decayed rock jack;
- an iron rebar bears S47°13'E, 28.97 feet;

The monument and references were tied using a LIECA system 300 RTK GPS.

Location and comments Compass Declination Surveyors Seal

RECEIVED BY:
 Morrow County Surveyor
 Date:
 Rec'd By:
 No.

Firm / Agency
 Haddock Surveying
 Address
 P. O. Box 1574
 Pendleton, Or. 97801
 Party Chief
 Stephen K, Haddock

