

OREGON CORNER RESTORATION FORM

Section 7 Township 4S Range 25E
County Morrow Date: April 24, 1999

Corner Designation: 4S25G1
quarter corner to section 7, R25E, and section 12, R24E of T4S, W.M., Morrow County, Oregon



Condition Report Only
Not found
Remonumented
Unrecorded
Surveyed in
Referenced out

Previous Renewals / Surveys, etc.

Corner originally set by Zenas F. Moody under contract No. 184 Dated March 29, 1873. His record reads: Set stone 14x12x9 in earth mound for 1/4 sec. cor.

Monument and Accessories found: (condition and source)

Found a record dimension stone in place in the dirt on the southeast corner of a rock jack at a three way fence intersection with fences running east west and north. The distance from this stone to the 1/4 stone 1 mile to the south agreed very well with the measurements between other monuments set under this same contract. The fence to the north was only remains.

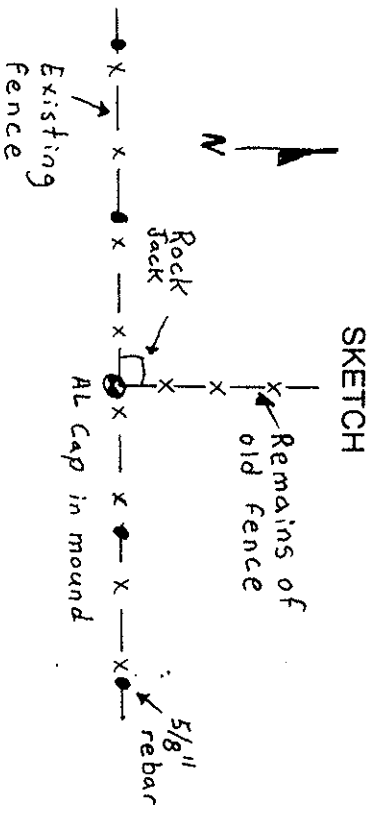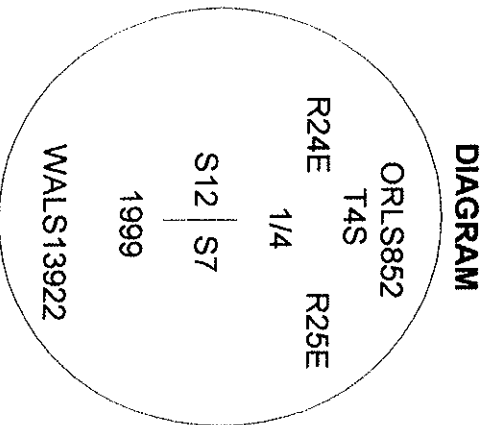

MONUMENT (S) AND ACCESSORIES SET (Procedures and Description)

Drove a 5/8"x24" rebar 18" into the bedrock with a 2" aluminum cap stamped as shown in the diagram above at the position of the stone and raised a small mound of stone and dirt around the cap to bury the record stone along side.

For references, I set four 5/8" by 24" rebars with 1.25" red plastic caps stamped ORLS 852 and WAL S 13922 as described below:

- an iron rebar bears S88°16'W, 37.90 feet under the existing fence;
- an iron rebar bears S88°04'W, 61.84 feet under the existing fence;
- an iron rebar bears N88°26'E, 48.24 feet under the existing fence;
- an iron rebar bears N88°20'E, 91.37 feet under the existing fence;

The monument and references were tied using a LIECA system 300 RTK GPS.

Location and comments

Compass Declination

Surveyors Seal

RECEIVED BY:
Morrow County Surveyor
Date:
Rec'd By:
No.

Firm / Agency
Haddock Surveying
Address
P. O. Box 1574
Pendleton, Or. 97801
Party Chief
Stephen K, Haddock



David L. Haddock

