

**OREGON CORNER RESTORATION FORM**

Section 7 Township 4S Range 25E  
 County Morrow Date: April 24, 1999

Corner Designation: 4S25J5

Corner to sections 7, 8, 17, and 18, T4S, R25E, W.M.  
 Morrow County, Oregon


Condition Report Only  
 Not found \_\_\_\_\_  
 Remonumented  \_\_\_\_\_  
 Unrecorded \_\_\_\_\_  
 Surveyed in \_\_\_\_\_  
 Referenced out  \_\_\_\_\_

Previous Renewals / Surveys, etc.


Corner originally set by Zenas F. Moody under contract No. 184 Dated March 29, 1873.  
 His record reads: Set stone 14x10x8 for cor. to secs. 7-8-5-6.

Monument and Accessories found: (condition and source)

Found a mound of stone approximately 3' south of an existing east-west fence with a record dimension stone in place in the center of the mound.

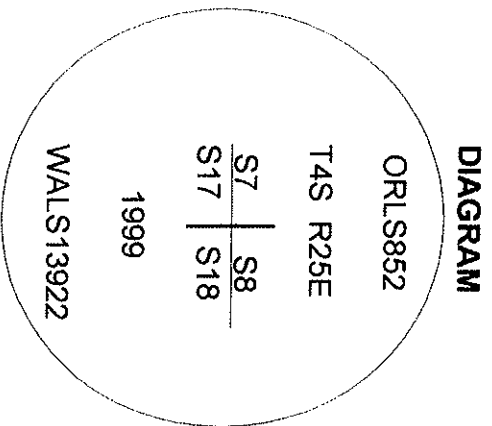

**DIAGRAM**

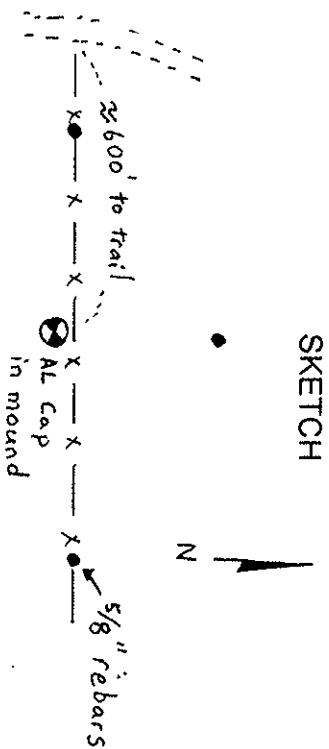

**SKETCH**

**MONUMENT (S) AND ACCESSORIES SET (Procedures and Description)**

Drove a 5/8"x24" rebar 22" into the ground with a 2" aluminum cap stamped as shown in the diagram above at the position of the stone and raised a mound of stone and around the cap. Buried the record stone along side the cap.

For references, I set three 5/8" by 24" rebars with 1.25" red plastic caps stamped ORLS 852 and WAL S 13922 as described below:

- an iron rebar bears N31°02'W, 37.71 feet;
- an iron rebar bears N20°23'E, 53.65 feet;
- an iron rebar bears S25°39'E, 59.03 feet;
- a railroad spike driven in a small rock outcrop bears S29°39'W, 59.03 feet;

The monument and references were tied using a LIECA system 300 RTK GPS.

Location and comments

Compass Declination

Surveyors Seal

RECEIVED BY:  
 Morrow County Surveyor  
 Date: \_\_\_\_\_  
 Rec'd By: \_\_\_\_\_  
 No. \_\_\_\_\_

Firm / Agency  
 Haddock Surveying  
 Address  
 P. O. Box 1574  
 Pendleton, Or. 97801  
 Party Chief  
 Stephen K, Haddock

**REGISTERED  
 PROFESSIONAL  
 LAND SURVEYOR**  
*David L Haddock*  
**OREGON**  
 JULY 12, 1968  
**DAVID L. HADDOCK**  
 852